


15-175-20679-0000

WELL PLUGGING RECORD

Give All Information Completely
Make Required Affidavit

COUNTY Seward SEC. 34 TWP. 32S RGE. 33 E/W
Location as in quarters or footage from lines:

C SW SW

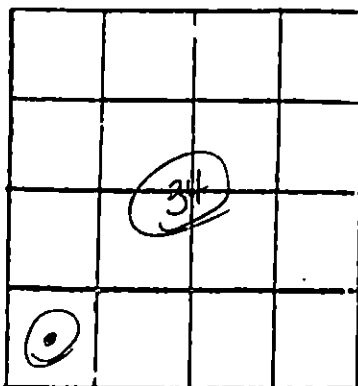

Locate Well
correctly on above
Section Platt.

Lease Owner Irex Corporation
Lease Name Lemert Well No. 1
Office Address 1670 Broadway, Suite 3301, Denver, CO 80303
Character of Well (Completed as Oil, Gas or Dry Hole): Dry Hole
Date Well Completed 3-16-83
Application for plugging filed 3-16-83
Plugging commenced 3-16-83
Plugging completed 3-16-83
Reason for abandonment of well or producing formation Dry Hole

Was permission obtained from the Conservation Division or it's
Agent's before plugging was commenced? yes

Name of Conservation Agent who supervised plugging of this well KCC Dodge City, KS

Producing formation — Depth to top — bottom — T.D. 6400

Show depth and thickness of all water, oil and gas formations.

OIL, GAS OR WATER RECORDS

Casing Record

Formation	Content	From	To	Size	Put in	Pulled Out
surface				8-5/8	1519	none

Describe in detail the manner in which the well was plugged, indicating where the mud
fluid was placed and the method or methods used in introducing it into the hold. If cement
or other plugs were used, state the character of same and depth placed, from — feet
to — feet for each plug set.

1st plug @ 1560' w/50 sx

2nd plug @ 660' w/25 sx

3rd plug @ 40' w/10 sx

10 sx in rat hole

10 sx in mouse hole

(If additional description is necessary, use BACK of this sheet)

Name of Plugging Contractor Murfin Drilling Co.

STATE OF Kansas COUNTY OF Sedgwick, ss.

David L. Murfin (employee of owner) or (owner or operator) of the
above-described well, being first duly sworn on oath, says: That I have knowledge of the
facts, statements, and matters herein contained and the log of the above-described well as
filed and that the same are true and correct. So help me God.

(Signature)

David L. Murfin

617 Union Center Bldg., (Address)
Wichita, KS 67202

SUBSCRIBED AND SWORN TO before me this 28th day of April, 1983



RAMONA GUNN
STATE NOTARY PUBLIC
Sedgwick county, Kansas
My Appt. Exp. Jan. 25, 1984

My Commission expires Jan. 25, 1984

Ramona Gunn
STATE CORPORATION COMMISSION Notary Public.

MAY 16 1983

CONSERVATION DIVISION
Wichita, Kansas

WELL LOG

COMPANY Irex Corporation

SEC. 34 T. 32S R. 33W
LOC. C SW SW

FARM Lemert NO. 1


RIG. NO. 22

TOTAL DEPTH 6400

COMM. 3-1-83

COMP. 3-16-83

COUNTY Seward
KANSAS

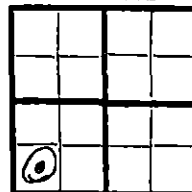

CONTRACTOR Murfin Drilling Co.

CASINO

20	10	600 sx Howco Lite, 3% CC	
15	8 - 5/8" @ 1519 w/800 sx	200 sx Class H, 3% CC	ELEVATION
12	6		
13	5		PRODUCTION

FIGURES INDICATE BOTTOM OF FORMATIONS

Surface Dirt	195
Red Bed	840
Lime & Shale	1519
Red Bed & Shale	1970
Lime & Shale	5570
Lime, Shale & Sand	5657
Lime & Shale RTD	6400

RECEIVED
STATE CORPORATION COMMISSION


MAY 16 1983

CONSERVATION DIVISION
Wichita, Kansas

State of Kansas }
County of Sedgwick } ss:

I, David L. Murfin of the Murfin Drilling Company

upon oath state that the above and foregoing is a true and correct copy of the log of the Lemert #1 well.

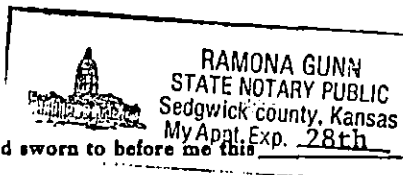

Subscribed and sworn to before me this 28th day of April 1983

My Commission Expires: Jan. 25, 1984

David L. Murfin

Ramona Gunn NOTARY PUBLIC