

STATE OF KANSAS
STATE CORPORATION COMMISSION

Form CP-4

WELL PLUGGING RECORD

Give All Information Completely
Make Required Affidavit
Mail or Deliver Report to:
Conservation Division
State Corporation Commission
212 No. Market
Wichita, Kansas

Seward County, Sec. 32 Twp. 32S Rge. 33 (K) W (W)

Location as "NE/CNW/SW" or footage from lines 1650 FSL & 2310' FWL

Lease Owner Cabot Corporation

Lease Name Ruth Fischer Well No. 1-32

Office Address P. O. Box 1101, Pampa, Texas 79065

Character of Well (completed as Oil, Gas or Dry Hole) Dry Hole

Date well completed 10-27 1970

Application for plugging filed 1970

Application for plugging approved 10-27 1970


Plugging commenced 10-27 1970

Plugging completed 10-27 1970

Reason for abandonment of well or producing formation Dry

If a producing well is abandoned, date of last production 19

Was permission obtained from the Conservation Division or its agents before plugging was commenced? Yes

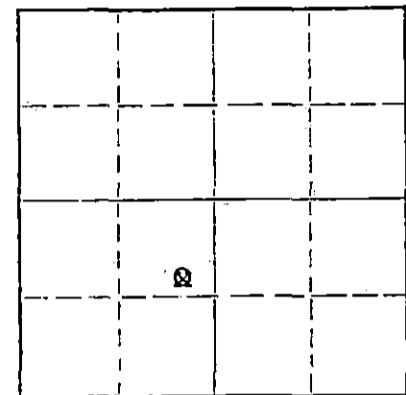

Locate well correctly on above Section Plat

Name of Conservation Agent who supervised plugging of this well Mr. Edgar J. Eves

Producing formation None Depth to top Bottom Total Depth of Well 6350 Feet

Show depth and thickness of all water, oil and gas formations.

OIL, GAS OR WATER RECORDS

CASING RECORD

FORMATION	CONTENT	FROM	TO	SIZE	PUT IN	PULLED OUT
				8 5/8	1638	- - -

Describe in detail the manner in which the well was plugged, indicating where the mud fluid was placed and the method or methods used in introducing it into the hole. If cement or other plugs were used, state the character of same and depth placed, from feet to feet for each plug set.

Plugging Record:

Hole filled with 9.4# Mud From 6357' to 2750'

Halliburton spotted 100 sacks Poz Mix From 2750' to 2450'

9.4# Mud From 2450' to 1100'

Halliburton spotted 35 sacks Poz Mix From 1100' to 1000'

9.4# Mud From 1000' to 50'

Halliburton spotted 15 sacks Poz Mix From 50' to 5'

Cut 8 5/8 csg 4' below ground and welded on 3/8" Metal cap.

RECEIVED
STATE CORPORATION COMMISSION
NOV 3 1970
CONSERVATION DIVISION
Wichita, Kansas

(If additional description is necessary, use BACK of this sheet)

Name of Plugging Contractor Leonard Hudson Drilling Company
Address P. O. Box 1876, Pampa, Texas 79065

STATE OF Texas, COUNTY OF Gray, ss.

Ray Wooldridge (employee of owner) or (owner or operator) of the above-described well, being first duly sworn on oath, says: That I have knowledge of the facts, statements, and matters herein contained and the log of the above-described well as filed and that the same are true and correct. So help me God.

(Signature) Ray Wooldridge
P. O. Box 1101, Pampa, Texas 79065
(Address)

SUBSCRIBED AND SWORN TO before me this 2 day of November 1970

My commission expires 6-1-71

Mildred Scott
Notary Public.

DRILLER'S LOG

Company:	Cabot Corporation	Commenced:	10-6-70
Farm:	Ruth Fischer No. 1-32	Completed:	10-27-70
Location:	1650' FSL & 2310' FWL	Contractor:	Leonard Hudson
	Section 32-32S-33W	Elevations:	2854' KB
	Seward County, Kansas		2852' DF
Casing:	8-5/8" @ 1640'/875 sacks		2842' GL
Perforations:	None	Total Depth:	6350' Rotary
			6357' Electric Log
		Production:	None - Dry & Abandoned

0 - 450'	Sand and Gravel
450 - 1030'	Red Bed and Gyp
1030 - 1600'	Red Bed, Sand, Gyp and Salt
1600 - 1640'	Anhydrite and Shale
1640 - 2160'	Red Bed and Anhydrite Shells
2160 - 2280'	Shale and Anhydrite
2280 - 2550'	Anhydrite and Shale
2550 - 2700'	Dolomite and Shale
2700 - 2870'	Lime and Shale
2870 - 3070'	Broken Lime and Shale
3070 - 3520'	Lime and Shale
3520 - 3750'	Lime
3750 - 4080'	Shale and Lime
4080 - 4250'	Lime and Shale
4250 - 4310'	Shale and Lime
4310 - 4910'	Lime and Shale
4910 - 5000'	Shale and Lime
5000 - 5170'	Lime and Shale
5170 - 5400'	Shale and Lime
5400 - 5560'	Shale and Lime Streaks
5560 - 5660'	Shale
5660 - 5770'	Shale, Sandy Lime and Sand
5770 - 5900'	Lime and Shale
5900 - 6030'	Limy Shale
6030 - 6110'	Lime and Sand
6110 - 6180'	Sandy Lime
6180 - 6350'	Lime and Chert
6350'	Driller's Total Depth

RECEIVED
STATE CORPORATION COMMISSION
NOV 9 1970
CONSERVATION DIVISION
Wichita, Kansas

Formation Tops:

Winfield	2660'
Toronto	4189'
Lansing	4307'
Marmaton	4982'
Cherokee	5181'
Morrow	5560'
Lower Morrow Sand	5754'
Mississippi-Chester	5772'
Ste. Genevieve	6106'
St. Louis	6180'