

STATE OF KANSAS
STATE CORPORATION COMMISSION

Form CP-4


Give All Information Completely
Make Required Affidavit
Mail or Deliver Report to:
Conservation Division
State Corporation Commission
211 No. Broadway
Wichita, Kansas

WELL PLUGGING RECORD

Seward County, Sec. 32 Twp. 32S Rge. (E) 33 (W)

Location as "NE/CNW%SW%" or footage from lines _____
Lease Owner Banks Oil Co.
Lease Name Fisher Well No. 1
Office Address 725 Union Center, Wichita, Kansas 67202
Character of Well (completed as Oil, Gas or Dry Hole) Dry Hole
Date well completed Feb. 28 1973
Application for plugging filed Feb. 28 1973
Application for plugging approved Feb. 28 1973
Plugging commenced 4:00 P.M. Feb. 28 1973
Plugging completed 10:00 P.M. Feb. 28 1973
Reason for abandonment of well or producing formation Dry Hole

NORTH

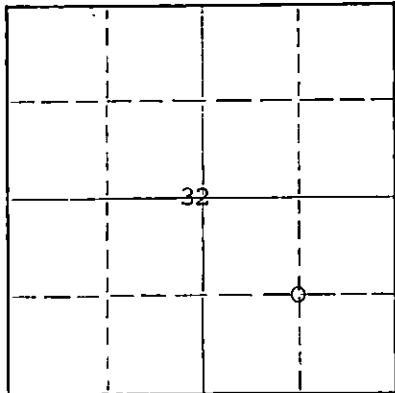

Locate well correctly on above
Section Plat

If a producing well is abandoned, date of last production N.A. 19
Was permission obtained from the Conservation Division or its agents before plugging was commenced? Yes

Name of Conservation Agent who supervised plugging of this well Edgar J. Eves
Producing formation _____ Depth to top _____ Bottom _____ Total Depth of Well 5800 KB Feet
Show depth and thickness of all water, oil and gas formations.

OIL, GAS OR WATER RECORDS

CASING RECORD

| FORMATION | CONTENT | FROM | TO | SIZE | PUT IN | PULLED OUT |
|-----------|---------|------|----|--------|--------|------------|
| | | | | 8 5/8" | 1586 | -0- |
| | | | | | | |
| | | | | | | |
Describe in detail the manner in which the well was plugged, indicating where the mud fluid was placed and the method or methods used in introducing it into the hole. If cement or other plugs were used, state the character of same and depth placed, from _____ feet to _____ feet for each plug set.

Spoted 35 sx. cement through open end drill pipe @ 1586', spot 15 sx. frm. 30' to bottom of cellar.

RECEIVED
STATE CORPORATION COMMISSION
MAR 13 1973
CONSERVATION DIVISION
Wichita, Kansas

(If additional description is necessary, use BACK of this sheet)

Name of Plugging Contractor Rine Drilling Company
Address 300 W. Douglas, Suite 600, Wichita, Kansas

STATE OF KANSAS, COUNTY OF SEDGWICK, ss.
R. M. Green (employee of owner) or (owner or operator) of the above-described well, being first duly sworn on oath, says: That I have knowledge of the facts, statements, and matters herein contained and the log of the above-described well as filed and that the same are true and correct. So help me God.

(Signature) R. M. Green R. M. Green
Suite 600-300 W. Douglas, Wichita, Kansas
(Address)

Subscribed and sworn to before me this 12th day of March, 19 73

My commission expires 3/31/75
NOTARY PUBLIC
SEDGWICK CO. KANS.

Carol J. Hladik
Carol J. Hladik
Notary Public.



FISHER WELL NO. 1

SE
SECTION 32-32S-33W
SEWARD COUNTY, KANSAS

CONTRACTOR: RINE DRILLING COMPANY

STARTED: FEBRUARY 13, 1973

COMPLETED: FEBRUARY 28, 1973

L O G

| | |
|----------------|------------------|
| Sand & Red Bed | 0' - 1570' |
| Anhydrite | 1570' - 2220' |
| Shale | 2220' - 2565' |
| Lime & Shale | 2565' - 5800' TD |

Totco - 1/4° @ 322'; 1/4° @ 568';
 1/2° @ 940'; 3/4° @ 1351'
 Totco - 3/4° @ 1586'; 1° @ 2153';
 Run 51 jts. of 8 5/8" csg. set @
 1586'. Cement w/550 sx. lt. wt.
 +2% cc. Follow w/150 sx. common
 +3% cc
 Totco - 1 1/2° @ 2313'
 Totco - 1 1/4° @ 2661'; 1 1/4° @
 3108'; 1 1/2° @ 3579; 1° @ 3983';
 1° @ 4127'; 1 1/4° @ 4681'; 1° @
 4859'; 1 1/4° @ 5495'; 1/2° @ 5800'
 Spot 35 sx., plug @ 1586'
 Spot 15 sx., plug @ 30'

STATE OF KANSAS)
COUNTY OF SEDGWICK) ss

I, R. M. Green, do hereby certify that the above is a true and accurate log of the Fisher Well No. 1., located SE of Section 32-32S-33W, Seward County, Kansas.

R. M. Green, Secretary-Treasurer

Subscribed and sworn to before me this 5th day of March, 1973.

J. W. Walker
T. W. Walker, Notary public

My Commission expires: 6/17/73

