


STATE OF KANSAS
STATE CORPORATION COMMISSION

Give All Information Completely
Make Required Affidavit
Mail or Deliver Report to:
Conservation Division
State Corporation Commission
800 Bitting Building
Wichita, Kansas

WELL PLUGGING RECORD

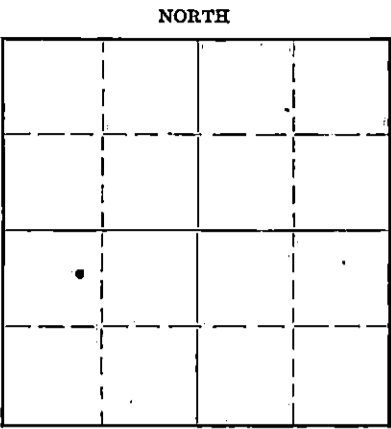

Locate well correctly on above
Section Flat

Pratt County. Sec. 25 Twp. 27 Rge. 12 (E) (W)
Location as "NE/CNW $\frac{1}{4}$ SW $\frac{1}{4}$ " or footage from lines C of E $\frac{1}{2}$ of NW 40 Ac. of SW 160 AC.
Lease Owner Hamilton Drlg. Co.
Lease Name Barnes Well No. 2
Office Address Mercantile Bank Bldg. Dallas, Texas
Character of Well (completed as Oil, Gas or Dry Hole) Dry Hole
Date well completed 3-13 19 52
Application for plugging filed 3-13 19 52
Application for plugging approved 3-13 19 52
Plugging commenced 3-13 19 52
Plugging completed 3-13 19 52
Reason for abandonment of well or producing formation Lost Circulation
If a producing well is abandoned, date of last production..... 19.....
Was permission obtained from the Conservation Division or its agents before plugging was commenced? Yes

Name of Conservation Agent who supervised plugging of this well M.A. Rives Box 148 Pratt, Kansas
Producing formation none Depth to top..... Bottom..... Total Depth of Well 2415 Feet
Show depth and thickness of all water, oil and gas formations.

OIL, GAS OR WATER RECORDS

CASING RECORD

Formation	Content	From	To	Size	Put In	Pulled Out
<u>Shale</u>				<u>8 5/8"</u>	<u>378</u>	<u>none</u>

Describe in detail the manner in which the well was plugged, indicating where the mud fluid was placed and the method or methods used in introducing it into the hole. If cement or other plugs were used, state the character of same and depth placed, from 0 feet to 370 feet for each plug set.
Pushed wooden plug to 370' displaced 15 sks. cement and filled hole from 370'. Back to 40' with heavy rotary mud. Pushed wooden plug to 40' and displaced 10 sks. cement. Cut csg. off at 4' below ground level.

(If additional description is necessary, use BACK of this sheet)

Correspondence regarding this well should be addressed to Hamilton Drlg. Co.
Address Mercantile Bank Bldg. Dallas, Texas

STATE OF Kansas, COUNTY OF Barton, ss.

..... (employee of owner) or (owner or operator) of the above-described well, being first duly sworn on oath, says: That I have knowledge of the facts, statements, and matters herein contained and the log of the above-described well as filed and that the same are true and correct. So help me God.

(Signature) T.D. Sweetman
1307 1/2 Main Great Bend, Kansas
(Address)

SUBSCRIBED AND SWORN to before me this 24 day of March, 19 52

My commission expires July 9, 1955
Notary Public.

22-7377-8 4-40-10M MAR 25 1952
3-25-1952

BOOK PAGE 1 LINE 17

DRILLERS LOG

Company: Hamilton Drlg. Co.

Section 25-27-12W

Farm: Barnes #2

Sec. CE/2 NW SW

Total Depth: 2415'

Pratt County, Kansas

Contractor: Anschutz Drlg. Co.

Elevation: 1752'

From	To	
0	75	Sand
75	390	Sand & Shells Set 378' 8 5/8" 2 1/2# csg. Cemented with 275 sks. cement, 3cc.
390	930	Shale & Shells
930	1065	Shale & Salt
1065	1350	Shale
1350	1570	Shale & Shells
1570	1725	Lime
1725	2005	Lime & Shale
2005	2415	Lime
		Total Depth

I CERTIFY THAT THIS IS THE TRUE AND CORRECT COPY OF THE ABOVE LOG, TO THE BEST OF MY KNOWLEDGE.

T. D. Sweetman

SUBSCRIBED AND SWORN TO BEFORE ME THIS 31 DAY OF March 1952.

Don E. Cromer
Notary Public

My Commission Expires July 9, 1955

PLUGGING
FILE SEC 25-27-12W
BOOK PAGE 1 LINE 17

APR 1 1952