


STATE OF KANSAS
STATE CORPORATION COMMISSION

WELL PLUGGING RECORD

Give All Information Completely
Make Required Affidavit
Mail or Deliver Report to:
Conservation Division
State Corporation Commission
211 No. Broadway
Wichita, Kansas

Pratt County, Sec. 25 Twp. 27S Rge. 12W (E) (W)

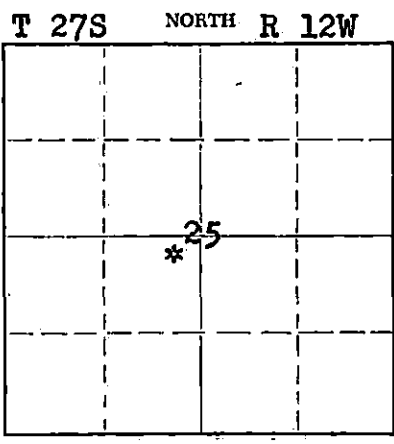

Locate well correctly on above Section Plat

Location as "NE/CNWxSWx" or footage from lines NE NE SW
Lease Owner Hamilton Brothers
Lease Name Barnes Well No. 1
Office Address 302 Petroleum Life Bldg. - Midland, Texas
Character of Well (completed as Oil, Gas or Dry Hole) _____
Date well completed _____ 19____
Application for plugging filed April 30 1956
Application for plugging approved _____ 19____
Plugging commenced May 3 1956
Plugging completed May 9 1956
Reason for abandonment of well or producing formation Depleted

If a producing well is abandoned, date of last production _____ 19____
Was permission obtained from the Conservation Division or its agents before plugging was commenced? Yes

Name of Conservation Agent who supervised plugging of this well Merle Rives
Producing formation _____ Depth to top _____ Bottom _____ Total Depth of Well 4434 Feet
Show depth and thickness of all water, oil and gas formations.

OIL, GAS OR WATER RECORDS

CASING RECORD

FORMATION	CONTENT	FROM	TO	SIZE	PUT IN	PULLED OUT
				8-5/8"	370'	None
				5-1/2"	4430'	3103'

Describe in detail the manner in which the well was plugged, indicating where the mud fluid was placed and the method or methods used in introducing it into the hole. If cement or other plugs were used, state the character of same and depth placed, from _____ feet to _____ feet for each plug set.

Filled the hole with sand from 8834' to 8410' and ran 5 sacks of cement. Pulled 5 1/2" casing up to 1800' and circulated hole with 25 sacks of jell mud. Pulled rest of casing, bailed mud to 300', set a 10' rock bridge and ran 25 sacks of cement to fill to 215'. Mudded the hole to 35', set a 10' rock bridge and ran 10 sacks of cement on top. Plugging completed.

RECEIVED
STATE CORPORATION COMMISSION

6-2-56 JUN 2 1956

CONSERVATION DIVISION

(If additional description is necessary, use BACK of this sheet)

Name of Plugging Contractor West Supply Co., Inc.
Address Chase, Kansas

STATE OF Texas, COUNTY OF Midland, ss:
Ferris F. Hamilton (employee of owner) or (owner or operator) of the above-described well, being first duly sworn on oath, says: That I have knowledge of the facts, statements, and matters herein contained and the log of the above-described well as filed and that the same are true and correct. So help me God.

(Signature) _____
Hamilton Brothers, Box 270, Midland, Texas
(Address)

SUBSCRIBED AND SWORN TO before me this 31st day of May, 1956
Barbara Koerner Barbara Koerner
Notary Public.

My commission expires June 1, 1957

PLUGGING
FILE SEC. 25 T. 27 R. 12W
BOOK PAGE 58 LINE 9

NE 1/4 NE 1/4 SW 25-27S-12W Pratt County, Kansas

Rigging up Rotary tools 11/6/51 Run 12 Jts. 8 5/8" Surface Pipe Set @370' with
Tearing down Rotary Tools 12/2/51 250 Sks. Cement

Run 141 Jts. 5 1/2" Casing Set @4430' with 250
sks. Cement

<u>FORMATION</u>	<u>FROM</u>	<u>TO</u>
Sand, Shale & Shells	0	370
Red Bed	370	580
Shale, Sand & Shells	580	660
Shale, redbed & shells	660	1093
Shale, Salt & Shells	1093	1532
Shale & Shells	1532	1630
Lime & Shale	1630	1730
Shale & Shells	1730	1950
Shale, sand & Lime	1950	2097
Shale & Lime	2097	2526
Shale & lime streaks	2526	2720
Shale & Lime & sand	2720	2809
Shale & lime	2809	3140
Shale, Lime & Sand	3140	3238
Lime & Shale	3238	3425
Shale & Sandy Lime	3425	3503
Shale & Lime	3503	3715
Shale, Lime & Sand	3715	3746
Lime & Shale Streaks	3746	3791
Lime	3791	3820
Lime & Shale	3820	4008
Lime & Chert	4008	4018
Lime	4018	4024
Lime & Chert	4024	4050
Chert	4050	4078
Chert & Shale	4078	4125
Shale & Lime	4125	4204
Shale & Chert	4204	4240
Chert, Lime & Shale	4240	4245
Cherty Dolomite	4245	4255
Chert & Shale	4255	4275
Shale & Lime Streaks	4275	4295
Shale	4295	4305
Shale & Sandy Lime	4305	4325
Shale & Sand	4325	4360
Sand	4360	4363
Sand Shale & Lime	4363	4381
Shale	4381	4411
Shale & Lime	4411	4430
		Total Depth

PLUGGING
FILE SEC 25-27-12W
BOOK PAGE 58 LINE 9

I, Don S. Packer, hereby certify that the above log is true and correct,
to the best of my knowledge and belief.

Don S. Packer

Subscribed and sworn to before me this 4th day of December, 1951.

CONSERVATION DIVISION
Wichita, Kansas

Harlan S. Mc Guinness
Notary Public

My Commission expires October 15, 1955