


STATE OF KANSAS
STATE CORPORATION COMMISSION

WELL PLUGGING RECORD

Give All Information Completely
Make Required Affidavit
Mail or Deliver Report to:
Conservation Division
State Corporation Commission
211 No. Broadway
Wichita, Kansas

Pratt County. Sec. 25 Twp. 27S Rge. 12W (E) (W)

T 27S NORTH R 12W

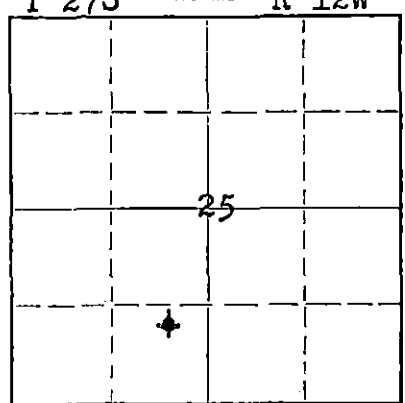

Locate well correctly on above Section Plat

Location as "NE/CNW/SW" or footage from lines SW/4
Lease Owner Hamilton Brothers
Lease Name Barnes Well No. 4
Office Address Petroleum Life Bldg. - Midland, Texas
Character of Well (completed as Oil, Gas or Dry Hole) Oil well
Date well completed October 31 19 52
Application for plugging filed April 30 19 56
Application for plugging approved 19
Plugging commenced April 30 19 56
Plugging completed May 4 19 56
Reason for abandonment of well or producing formation

If a producing well is abandoned, date of last production 19
Was permission obtained from the Conservation Division or its agents before plugging was commenced? Yes

Name of Conservation Agent who supervised plugging of this well Merle Rives
Producing formation Depth to top Bottom Total Depth of Well 4385 Feet
Show depth and thickness of all water, oil and gas formations.

OIL, GAS OR WATER RECORDS

CASING RECORD

FORMATION	CONTENT	FROM	TO	SIZE	PUT IN	PULLED OUT
				8-5/8"	813'	None
				5-1/2"	3835'	3223'
				13-3/8"	134'	None
				Hole was plugged back to 3850'.		

Describe in detail the manner in which the well was plugged, indicating where the mud fluid was placed and the method or methods used in introducing it into the hole. If cement or other plugs were used, state the character of same and depth placed, from feet to feet for each plug set.

Filled the hole with sand from 3850' to 3830' and ran 5 sacks of cement. Pulled casing up to 1800' and pumped in 30 sacks of jell mud to circulate hole. Pulled rest of casing and bailed mud to 300'. Set a 10' rock bridge at 300' and ran 25 sacks of cement. Mudded the hole to 35', set a rock bridge and ran 10 sacks of cement to fill to base of cellar. Plugging completed.

6-2-56

(If additional description is necessary, use BACK of this sheet)
Name of Plugging Contractor West Supply Co., Inc.
Address Chase, Kansas

STATE OF Texas, COUNTY OF Midland, ss.
Ferris F. Hamilton (employee of owner) or (owner or operator) of the above-described well, being first duly sworn on oath, says: That I have knowledge of the facts, statements, and matters herein contained and the log of the above-described well as filed and that the same are true and correct. So help me God.

(Signature) [Signature]
Hamilton Brothers, Box 270, Midland, Texas (Address)

SUBSCRIBED AND SWORN TO before me this 31st day of May 1956

[Signature] Barbara Kaerner Notary Public.

My commission expires June 1, 1957

PLUGGING
FILE SEC. 25 T. 27 R. 12W
BOOK PAGE 58 LINE 10

Company Hamilton Brothers

C N / 2 S E 5 W

990' FROM SOUTH LINE
660' FROM EAST LINE, SW/4
SEC. 25-27S-12W
PRATT COUNTY, KANSAS

BARNES WELL No. 4

CONTRACTOR: THE R. W. RINE DRILLING COMPANY

STARTED: OCTOBER 11, 1952

FINISHED: OCTOBER 31, 1952

	LOG		
SAND, CLAY	0	115	
RED BED	115	140	13-3/8" Csg. @ 134' w/150 sx. (CIRC.)
CEMENT	120	135	
RED BED	135	290	
RED BED, SHELLS, SHALE	290	720	SYFO @ 500' - 1/2"
SAND, SHELLS	720	750	
ANHYDRITE	750	775	
RED BED, SHALE	775	1232	8-5/8" Csg. @ 813' w/450 sx. (CIRC.)
CEMENT	795	815	SYFO @ 1000' - 1/2"
SHELLS, SHALE, SALT	1232	1555	SYFO @ 1500' - 1/2"
LIME	1555	1657	
LIME, SAND	1657	1770	
LIME	1770	2070	SYFO @ 2000' - OK
LIME, SHALE	2070	2320	
LIME, SHELLS	2320	2410	
LIME, SHALE	2410	2810	SYFO @ 2500' - OK
LIME	2810	2925	
LIME, SHALE	2925	3335	SYFO @ 3000' - OK
BROKEN LIME	3335	3440	
LIME	3440	4039	SYFO @ 3500' - OK
CHERT	4039	4100	SYFO @ 4000' - OK
CHERT, LIME	4100	4145	
LIME, SHALE	4145	4200	
CHERT, LIME	4200	4265	
LIME	4265	4344	
LIME, SAND	4344	4367	
SAND	4367	4385	TD-5-1/2" Csg. @ 3835' w/65 sx. CEMENT 12 SX. STRATACRETE

I, R. M. GREEN, DO HEREBY CERTIFY THAT THE ABOVE IS A TRUE AND ACCURATE LOG OF THE BARNES WELL No. 4, LOCATED 990 FEET FROM SOUTH LINE AND 660 FEET FROM EAST LINE, SW/4, SEC. 25-27S-12W, PRATT COUNTY, KANSAS.

R. M. Green
ASSISTANT SECRETARY

SUBSCRIBED TO AND SWORN BEFORE ME THIS 5TH DAY OF NOVEMBER, 1952.

Leonal Pederson
NOTARY PUBLIC

MY COMMISSION EXPIRES APRIL 20, 1955.

PLUGGING
FILE SEC 25 T 27 R 12W
BOOK PAGE 58 LINE 10