

STATE OF KANSAS
STATE CORPORATION COMMISSION

WELL PLUGGING RECORD

Give All Information Completely
Make Required Affidavit
Mail or Deliver Report to
Conservation Division
State Corporation Comm.
245 North Water
Wichita, KS 67202

Pratt County, Sec. 24 Twp. 29S Rge. 14 E/W
Location as "NE/CNW/SW" or footage from lines
330 FNL 1980 FEL

Lease Owner Texas Oil & Gas
Lease Name Alvin Skiles Well No. 2
Office Address 200 W. Douglas, Suite 300, Wichita, Ks
Character of Well (Completed as Oil, Gas or Dry Hole)
oil well


Date Well completed March 10 1980
Application for plugging filed 6-10 1981
Application for plugging approved 6-11 1981
Plugging commenced 6-16 1981
Plugging completed 6-22 1981

Reason for abandonment of well or producing formation
not productive

If a producing well is abandoned, date of last production
19

Was permission obtained from the Conservation Division or
its agents before plugging was commenced? yes

Name of Conservation Agent who supervised plugging of this well M. V. Leslie
Producing formation Depth to top Bottom Total Depth of Well 4726
Show depth and thickness of all water, oil and gas formations.

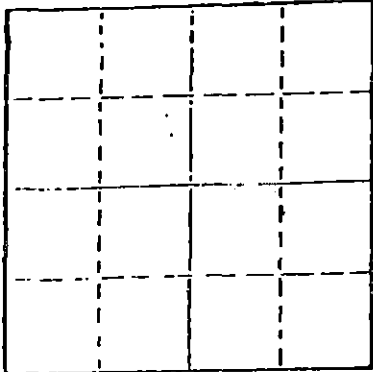

Locate well correctly on above
Section Plat

OIL, GAS OR WATER RECORDS

CASING RECORD

FORMATION	CONTENT	FROM	TO	SIZE	PUT IN	PULLED OUT
				10 3/4	461	None
				4 1/2	4723	3549

Describe in detail the manner in which the well was plugged, indicating where the mud fluid
was placed and the method or methods used in introducing it into the hold. If cement or other
plugs were used, state the character of same and depth placed, from feet to
feet for each plug set.

Dumped sand. Covered perforation.
Sand from 4518 to 4480
4 sacks cement from 4480 to 4460
Ripped at 4000 feet
Ripped 3549. Pulled 45 feet.

Allied pumped in 15 gel, 8 hull, 10 gel
225 sacks 50-50-POZ 4% gel 3% CC.

(If additional description is necessary, use BACK of this sheet)

Name of Plugging Contractor Clarke Corporation

STATE OF Kansas COUNTY OF Barber, ss.
Elmo R. Morquestern (employee of owner) or (owner or operator)
of the above-described well, being first duly sworn on oath, says: That I have knowledge of
the facts, statements, and matters herein contained and the log of the above-described well
as filed and that the same are true and correct. So help me God.

(Signature) Elmo R. Morquestern
Medicine Lodge, Ks.
(address)

SUBSCRIBED AND SWORN TO before me this 23rd day of June, 1981

Jessie Hamerton
Notary Public.

My commission expires April 4, 1982

RECEIVED
STATE CORPORATION COMMISSION

JUN 29 1981

CONSERVATION DIVISION
Wichita, Kansas