


15.151-20255-50-00

STATE OF KANSAS  
STATE CORPORATION COMMISSION  
CONSERVATION DIVISION  
P. O. BOX 17027  
WICHITA, KANSAS 67217

FORM CP-4

WELL PLUGGING RECORD

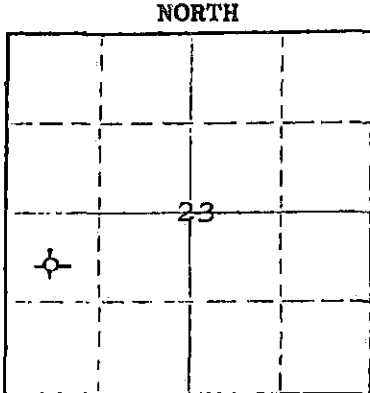

Locate well correctly on above Section Plat

Pratt County, Sec. 23 Twp. 29S Rgc. 13W (W)  
Location as "NE/CNW&SW" or footage from lines C S/2 NW SW  
Lease Owner John O. Farmer, Inc.  
Lease Name Kinzie Well No. 2  
Office Address Box 352, Russell, Kansas 67665  
Character of Well (completed as Oil, Gas or Dry Hole) Dry Hole  
Date well completed April 15, 19 75  
Application for plugging filed April 15, 19 75  
Application for plugging approved April 15, 19 75  
Plugging commenced April 15, 19 75  
Plugging completed April 15, 19 75  
Reason for abandonment of well or producing formation Dry Hole

If a producing well is abandoned, date of last production 19  
Was permission obtained from the Conservation Division or its agents before plugging was commenced? Yes

Name of Conservation Agent who supervised plugging of this well  
Producing formation Depth to top Bottom Total Depth of Well 4693 Feet  
Show depth and thickness of all water, oil and gas formations.

OIL, GAS OR WATER RECORDS

CASING RECORD

FORMATION	CONTENT	FROM	TO	SIZE	PUT IN	FULLED OUT
		0'	207'	10-3/4"	207'	None

Describe in detail the manner in which the well was plugged, indicating where the mud fluid was placed and the method or methods used in introducing it into the hole. If cement or other plugs were used, state the character of same and depth placed, from feet to feet for each plug set.

- 4693'-210' - Hole filled with mud & hulls.
- 210'-206' - Plug
- 206'-40' - Cement, 35 sacks
- 40'-36' - Plug
- 36'-6' - Cement, 15 sacks (bottom of cellar).  
2 sacks cement in rat hole.

(If additional description is necessary, use BACK of this sheet)  
Name of Plugging Contractor Allied Cementing Co.  
Address Pratt, Kansas

STATE OF KANSAS COUNTY OF SEDGWICK  
John D. Knightley (Agent) (employee of owner) or (owner or operator) of the above-described well, being first duly sworn on oath, says: That I have knowledge of the facts, statements, and matters herein contained and the log of the above-described well as filed and that the same are true and correct. So help me God.

(Signature) [Signature]  
301 S. Broadway, Wichita, Kansas  
(Address)

Subscribed and Sworn to before me this 17th day of April, 19 75

My commission expires March 12, 1979  
[Signature] Notary Public.

John O. Farmer, Inc. - Kinzie #2  
C S/2 NW SW Sec. 23-29S-13W  
Pratt County, Kansas

Contractor: D. R. Lauck Oil Company, Inc.  
301 S. Broadway  
Wichita, Kansas 67202

Commenced: April 3, 1975  
Completed: April 15, 1975

Drillers Log

Clay & Sand	40
Sand	182
Shale	210
Red Bed	730
Shale	1330
Shale & Lime	1895
Shale & Shells	2055
Shale & Lime	3830
Lime	4535
Lime & Shale	4580
Shale & Sand	4590
Lime	4693 RTD

RECEIVED  
STATE CORPORATION COMMISSION  
APR 18 1975  
CONSERVATION DIVISION  
Wichita, Kansas