


15-151-20680-00-50

STATE OF KANSAS  
STATE CORPORATION COMMISSION

WELL PLUGGING RECORD

Give All Information Completely  
Make Required Affidavit  
Mail or Deliver Report to:  
Conservation Division  
State Corporation Commission  
211 No. Broadway  
Wichita, Kansas

Pratt County. Sec. 27 Twp. 29 Rge. 13 (~~E~~) X (W)  
Location as "NE/CNW%SW%" or footage from lines SW NW NW  
Lease Owner National Oil Company  
Lease Name Larrison #1 Well No. \_\_\_\_\_  
Office Address 200 West Douglas, Suite 550 Wichita, Kansas 67202  
Character of Well (completed as Oil, Gas or Dry Hole) D & A  
Date well completed October 30, 1979  
Application for plugging filed October 30, 1979  
Application for plugging approved October 30, 1979  
Plugging commenced October 30, 1979  
Plugging completed October 30, 1979  
Reason for abandonment of well or producing formation D & A

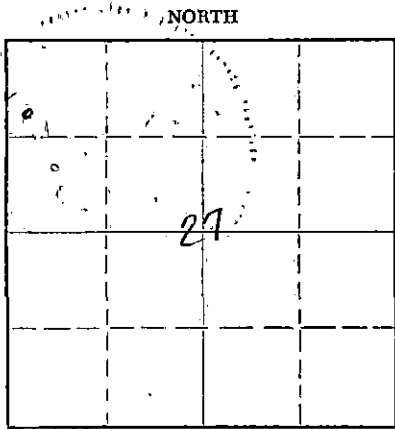

Locate well correctly on above  
Section Plat

If a producing well is abandoned, date of last production \_\_\_\_\_ 19\_\_\_\_  
Was permission obtained from the Conservation Division or its agents before plugging was commenced? Yes

Name of Conservation Agent who supervised plugging of this well William T. Owen  
Producing formation Simpson Depth to top 4615 Bottom \_\_\_\_\_ Total Depth of Well 4640 Feet  
Show depth and thickness of all water, oil and gas formations.

OIL, GAS OR WATER RECORDS

CASING RECORD

FORMATION	CONTENT	FROM	TO	SIZE	PUT IN	PULLED OUT
				10 3/4	320	-0-

Describe in detail the manner in which the well was plugged, indicating where the mud fluid was placed and the method or methods used in introducing it into the hole. If cement or other plugs were used, state the character of same and depth placed, from \_\_\_\_\_ feet to \_\_\_\_\_ feet for each plug set.

Heavy mud from TD to 600', 40 sks cement plug mud to 300', 50 sks cement plug mud to 40' 1/2 sk. hulls plug bridged. 20 sks. to base of cellar 3' sks. in rat hole. Completed at 8:45 p.m., October 30, 1979.

RECEIVED  
STATE CORPORATION COMMISSION  
NOV 19 1979  
CONSERVATION DIVISION  
Wichita, Kansas

(If additional description is necessary, use BACK of this sheet)

Name of Plugging Contractor Venture Drilling Inc.  
Address 1625 Vickers-KSB&T Bldg., Wichita, Kansas 67202

STATE OF Kansas, COUNTY OF Sedgewick, ss.  
Jimmy Munkhof (employee of owner) or (owner or operator) of the above-described well, being first duly sworn on oath, says: That I have knowledge of the facts, statements, and matters herein contained and the log of the above-described well as filed and that the same are true and correct. So help me God.

(Signature) Jimmy Munkhof  
200 W. Douglas St. 550 (Address)

SUBSCRIBED AND SWORN to before me this 15th day of November, 1979



Lynette Sullick  
Notary Public.



November 1, 1979

WELL LOG

SUITE 1625 KSB&T BLDG. 125 NORTH MARKET WICHITA, KANSAS 67202 (316) 267-1550

#1 LARRISON

Operator:

National Oil Company  
200 West Douglas  
Wichita, Kansas 67202

Rotary Drilling Contractor

Venture Drilling Inc.  
Suite 1625 Vickers-KSB&T Bldg.  
Wichita, Kansas 67202

R.T.D. 4645'

Commenced: October 19, 1979  
Plugged Well: October 30, 1979

LOG

0'	-	275'	Sand and Red bed
275'	-	335'	Red Bed
335'	-	360'	Red Bed
360'	-	1069'	Red Bed
1069'	-	1101'	Red Bed
1101'	-	1265'	Red Bed
1265'	-	1930'	Lime & Shale
1930'	-	2143'	Sandy Shale
2143'	-	2290'	Shale
2290'	-	2505'	Lime and Shale
2505'	-	2740'	Shale and Sand
2740'	-	2940'	Lime and Shale
2940'	-	3130'	Lime and Shale
3130'	-	3315'	Lime and Shale
3315'	-	3430'	Lime and Shale
3430'	-	3620'	Lime and Shale
3620'	-	3810'	Lime and Shale
3810'	-	3915'	Lime and Shale
3915'	-	4022'	Lime and Shale
4022'	-	4104'	Lime and Shale
4104'	-	4226'	Lime and Shale
4226'	-	4246'	Lime and Shale
4246'	-	4345'	Lime and Shale
4345'	-	4433'	Lime and Shale
4433'	-	4445'	Lime and Shale
4445'	-	4540'	Lime and Shale
4540'	-	4645'	Lime and Shale
4645'	-		RTD

Spudded at 8:30 p.m.

Casing Record

8 jts. 10 3/4" 30# New set  
@ 320' w/300 sks. class "A"  
3% cc w/ 1/4# Flocele/sk.  
Plug down at 9:00 p.m.  
Cement did Circulate.

RECEIVED  
STATE CORPORATION COMMISSION

NOV 16 1979

CONSERVATION DIVISION  
Wichita, Kansas

Plugging Information

Heavy mud from TD to 600' 40  
SK Cement Plug, Mud to 300' 50  
SK Cement plug mud to 40' 1/2  
SK of hulls plug bridged 20  
Sks. in base of cellar, 3 sks. in  
tar hole. Completed at 8:45 p.m.  
by Halliburton. Instruction by  
Bell Owen of Pratt.

REC'D NOV 2 1979