


STATE OF KANSAS  
STATE CORPORATION COMMISSION

WELL PLUGGING RECORD

Give All Information Completely  
Make Required Affidavit  
Mail or Deliver Report to  
Conservation Division  
State Corporation Comm.  
245 North Water  
Wichita, KS 67202

Kiowa County, Sec. 15 Twp. 27S Rge. 17W E/W  
Location as "NE/CNW $\frac{1}{4}$ SW $\frac{1}{4}$ " or footage from lines \_\_\_\_\_

C SW SW  
Lease Owner Dunne-Gardner Petroleum, Inc.  
Lease Name Curtis Well No. 1  
Office Address Suite 250, 200 W. Douglas, Wichita, KS  
Character of Well (Completed as Oil, Gas or Dry Hole) \_\_\_\_\_  
Dry hole

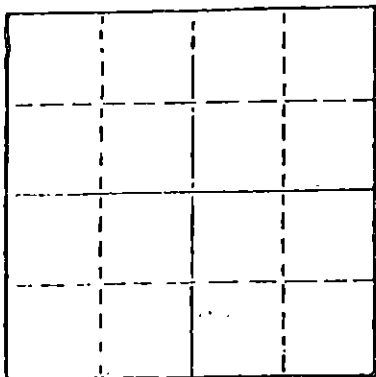

Locate well correctly on above  
Section Plat

Date Well completed November 23, 1977  
Application for plugging filed November 23, 1977  
Application for plugging approved November 23, 1977  
Plugging commenced November 23, 1977  
Plugging completed November 23, 1977  
Reason for abandonment of well or producing formation \_\_\_\_\_  
Dry hole

If a producing well is abandoned, date of last production \_\_\_\_\_  
19

Was permission obtained from the Conservation Division or  
its agents before plugging was commenced? yes

Name of Conservation Agent who supervised plugging of this well Bill Owens  
Producing formation \_\_\_\_\_ Depth to top \_\_\_\_\_ Bottom \_\_\_\_\_ Total Depth of Well 5030'  
Show depth and thickness of all water, oil and gas formations.

OIL, GAS OR WATER RECORDS.

CASING RECORD.

FORMATION	CONTENT	FROM	TO	SIZE	PUT IN	PULLED OUT
				8-5/8"	445'	-

Describe in detail the manner in which the well was plugged, indicating where the mud fluid  
was placed and the method or methods used in introducing it into the hold. If cement or other  
plugs were used, state the character of same and depth placed, from \_\_\_\_\_ feet to  
\_\_\_\_\_ feet for each plug set.

Mud to 450', 40 sacks cement  
Mud to 40', plug, 1/2 sack hulls and 12 sacks cement  
3 sacks cement in rat hole

RECEIVED  
STATE CORPORATION COMMISSION

DEC 01 1977

CONSERVATION DIVISION  
Wichita, Kansas

(If additional description is necessary, use BACK of this form)  
Name of Plugging Contractor \_\_\_\_\_

STATE OF KANSAS COUNTY OF SEDGWICK, ss.  
Don Gardner (owner or operator)

of the above-described well, being first duly sworn on oath, says: That I have knowledge of  
the facts, statements, and matters herein contained and the log of the above-described well  
as filed and that the same are true and correct. So help me God.

(Signature)

Suite 250, 200 West Douglas, Wichita, KS  
(Address)

SUBSCRIBED AND SWORN TO before me this 29th day of November, 1977

Kathleen L. Durbin  
Notary Public.

My commission expires January 4, 1981

DRILLERS LOG

#1 CURTIS  
C SW SW Section 15-27S-17W  
Kiowa County, Kansas

OPERATOR: DUNNE-GARDNER PETROLEUM, INC.  
Suite 250, 200 West Douglas  
Wichita, Kansas 67202

CONTRACTOR: DUNNE-GARDNER PETROLEUM, INC.  
Suite 250, 200 West Douglas  
Wichita, Kansas 67202

COMMENCED: November 13, 1977

COMPLETED: November 23, 1977


CASING RECORD: 8-5/8" @ 445' w/325 sx

<u>FROM</u>	<u>TO</u>	<u>DESCRIPTION</u>
0	425	Sand and blue shale
425	445	Blue shale
445	1070	Shells and shale
1070	1976	Anhydrite
1976	4123	Shale and lime
4123	4875	Lime
4875	4970	Lime and shale
4970	5030	Lime
5030		Rotary total depth

RECEIVED  
STATE CORPORATION COMMISSION  
DEC 01 1977  
CONSERVATION DIVISION  
Wichita, Kansas

STATE OF KANSAS )  
                          ) ss  
COUNTY OF SEDGWICK)

I hereby certify that the above is a true and correct log to the best of my knowledge and belief.

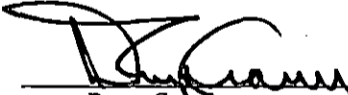  
\_\_\_\_\_  
Don Gardner

Subscribed and sworn to before me this 29th day of November, 1977.

My appointment expires:  
January 4, 1981

  
\_\_\_\_\_  
Kathleen L. Durbin  
Notary Public

