

STATE CORPORATION COMMISSION OF KANSAS  
OIL & GAS CONSERVATION DIVISION

WELL COMPLETION OR RECOMPLETION FORM  
ACO-1 WELL HISTORY

DESCRIPTION OF WELL AND LEASE

Operator: license # 5118  
name TGT Petroleum Corp.  
address 209 E. William  
City/State/Zip Wichita, Ks. 67202

Operator Contact Person B. Lynn Herrington  
Phone 262-6489

Contractor: license # 5422  
name Abercrombie Drilling, Inc.

Wellsite Geologist Al Stude  
Phone 262-0902

PURCHASER

Designate Type of Completion

New Well  Re-Entry  Workover

Oil  SWD  Temp Abd  
 Gas  Inj  Delayed Comp.  
 Dry  Other (Core, Water Supply etc.)

If OWWO: old well info as follows:

Operator  
Well Name  
Comp. Date Old Total Depth

WELL HISTORY

Drilling Method:  Mud Rotary  Air Rotary  Cable

2-13-85 2-28-85 3-1-85  
Spud Date Date Reached TD Completion Date

4980  
Total Depth PBD

Amount of Surface Pipe Set and Cemented at 421.73 @ 434 feet

Multiple Stage Cementing Collar Used?  Yes  No

If Yes, Show Depth Set feet

If alternate 2 completion, cement circulated  
from feet depth to w/ SX cmt

API NO. 15-097-21,107-0000

County Kiowa

NE SW Sec 29 Twp 27S Rge 18  
(location)

1980 Ft North from Southeast Corner of Sec  
3300 Ft West from Southeast Corner of Sec  
(Note: locate well in section plat below)


Lease Name Rosenberger Well# 1

Field Name

Producing Formation

Elevation: Ground 2200 KB 2212

Section Plat

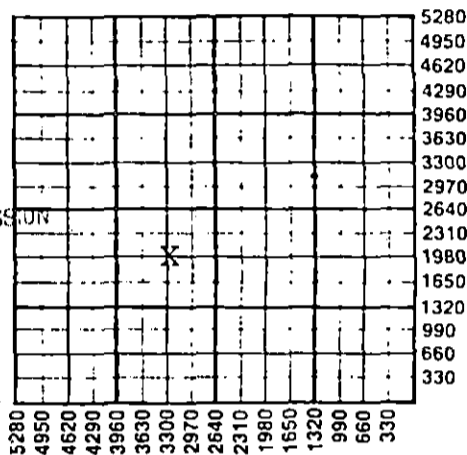

RECEIVED

MAY 20 1985

STATE CORPORATION COMMISSION  
OIL & GAS CONSERVATION DIVISION  
Wichita, Kansas

5-20-1985

WATER SUPPLY INFORMATION

Source of Water:

Division of Water Resources Permit #

Groundwater 2310 Ft North From Southeast Corner  
(Well) 3300 Ft. West From Southeast Corn  
Sec 29 Twp 27S Rge 18  East  West

Surface Water Ft North From Southeast Corner  
(Stream, Pond etc.) Ft West From Southeast C  
Sec Twp Rge  East  West

Other (explain)  
(purchased from city, R.W.D.#)

Disposition of Produced Water:  Disposal  Repressuring

Docket #

INSTRUCTIONS: This form shall be completed in duplicate and filed with the Kansas Corporation Commission, 200 Colorado Derby Building, Wichita, Kansas 67202, within 90 days after completion or recompletion of any well. Rules 82-3-130 and 82-3-107 apply.

Information on side two of this form will be held confidential for a period of 12 months if requested in writing and submitted with the form. See rule 82-3-1 for confidentiality in excess of 12 months.


One copy of all wireline logs and drillers time log shall be attached with this form. Submit CP-4 form with all plugged wells. Submit CP-111 form with all temporarily abandoned wells.

All requirements of the statutes, rules, and regulations promulgated to regulate the oil and gas industry have been fully complied with and the statements herein are complete and correct to the best of my knowledge.

Signature B. Lynn Herrington  
Title Executive Vice-President Date 5-15-85

Subscribed and sworn to before me this 15th day of May 19 85

Notary Public Judith K. Moser  
Date Commission Expires 5-17-85

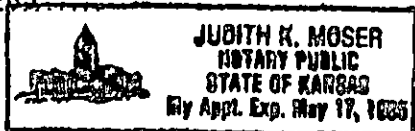

K.C.C. OFFICE USE ONLY  
 Letter of Confidentiality Attached  
 Wireline Log Received  
 Drillers Timelog Received  
Distribution  
 KCC  SWD/Rep  NGPA  
 KGS  Plug  Other (Specify)

Sec. 27, Twp. 27S, Rge. 18W