

AFFIDAVIT AND COMPLETION FORM

ACO-1

This form must be filed in triplicate with the Kansas Corporation Commission, 200 Colorado Derby Building, Wichita, Kansas 67202, within five days after the completion of the well, regardless of how the well was completed. Circle one: Oil + gas, dry, SWD, OWWO, injection. Please type. Complete ALL sections. Applications must be filed for dual completion, commingling, salt water disposal and injection. Attach wireline logs (i.e. electrical log, sonic log, gamma ray neutron log, etc.) KCC#-(316) 263-3238.


OPERATOR Beren Corporation API NO. 15-097-20,831-0000  
 ADDRESS 970 Fourth Financial Center COUNTY Kiowa  
Wichita, Kansas 67202 FIELD CARDIFF/BORPINS W  
 \*\*CONTACT PERSON Melvyn Abels LEASE Kelton "A"  
 PHONE (316) 265-3311 PROD. FORMATION \_\_\_\_\_

\*\*\*PURCHASER Panhandle Eastern Pipe Line Company WELL NO. 1  
 ADDRESS P.O. Box 1348 WELL LOCATION SE SW  
Kansas City, Missouri 64141 \_\_\_\_\_ Ft. from \_\_\_\_\_ Line and  
 \_\_\_\_\_ Ft. from \_\_\_\_\_ Line of  
 DRILLING CONTRACTOR Sterling Drilling Company the SEC. 12 TWP. 27S RGE. 16W

ADDRESS P.O. Box 129  
Sterling, Kansas 67579

PLUGGING CONTRACTOR \_\_\_\_\_  
 ADDRESS \_\_\_\_\_

TOTAL DEPTH 4581 PBTD \_\_\_\_\_  
 SPUD DATE 10/16/81 DATE COMPLETED 10/26/81  
 ELEV: GR 2081 DF \_\_\_\_\_ KB \_\_\_\_\_

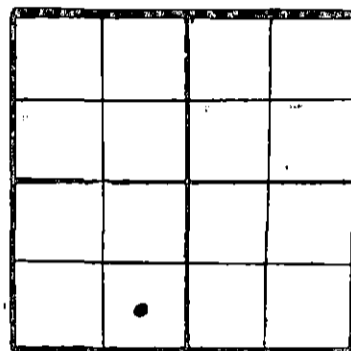

WELL PLAT  
 (Quarter) or (Full) Section - Please indicate.

KCC \_\_\_\_\_  
 KGS \_\_\_\_\_  
 MISC. \_\_\_\_\_

DRILLED WITH (ROTARY) TOOLS  
 Report of all strings set — surface, intermediate, production, etc. (New) / \_\_\_\_\_ casing.

Purpose of string	Size hole drilled	Size casing set (in O.D.)	Weight lbs/ft.	Setting depth	Type cement	Sacks	Type and percent additives
Surface		8-5/8"		445	60-40 pozmix	300	2% gel, 3% CC
Production		5 1/2"	14#	4580	60-40 pozmix	250	2% gel, 10% salt

LINER RECORD			PERFORATION RECORD		
Top, ft.	Bottom, ft.	Sacks cement	Shots per ft.	Size & type	Depth interval
			2	DP jets	4560-64
TUBING RECORD			2	DP	4560-75
Size	Setting depth	Packer set at			
2-3/8	4545	NA			

ACID, FRACTURE, SHOT, CEMENT SQUEEZE RECORD	
Amount and kind of material used	Interval treated
Acidize with 1000 gal 15% HCl - frac with 23,000# sand and 29,000 gallons cross linked gel	4560-75

TEST DATE: 12-22-81		PRODUCTION	
Date of first production	Producing method (flowing, pumping, gas lift, etc.)	A.P.I. Gravity	
12-22-81	Flowing	35.6	
RATE OF PRODUCTION PER 24 HOURS		Gas-oil ratio	
Oil 172 bbls.	Gas 870 MCF	Water 0 %	5000 CFPB
Disposition of gas (vented, used on lease or sold)		Producing interval (s)	
Vented		4560-75	

\*\* The person who can be reached by phone regarding any questions concerning this information.  
 A witnessed initial test by the Commission is required if the well produces more than 25 BOPD or is located in a Basic Order Pool.

\*\*\*Central Crude Corporation  
 402 Commerce Plaza  
 Wichita, Kansas 67202

Name of lowest fresh water producing stratum \_\_\_\_\_ Depth \_\_\_\_\_  
 Estimated height of cement behind pipe \_\_\_\_\_

**WELL LOG**

Show all important zones of porosity and contents thereof; cored intervals, and all drill-stem tests, including depth interval tested, cushion used, time tool open, flowing and shut-in pressures, and recoveries.

SHOW GEOLOGICAL MARKERS, LOGS RUN, OR OTHER DESCRIPTIVE INFORMATION.

FORMATION DESCRIPTION, CONTENTS, ETC.	TOP	BOTTOM	NAME	DEPTH
Sand	0	260		
Shale	260	1085		
Anhydrite	1085	1100		
Shale	1100	2175		
Lime and shale	2175	4500		
Lime - chert	4500	4538		
Lime and shale	4538	4581		
RTD	4581			

USE ADDITIONAL SHEETS, IF NECESSARY, TO COMPLETE WELL RECORD.

A F F I D A V I T

STATE OF KANSAS, COUNTY OF SEDGWICK SS,

DON W. BEAUCHAMP OF LAWFUL AGE, BEING FIRST DULY SWORN UPON HIS OATH, DEPOSES AND SAYS:

THAT HE IS GEOLOGIST FOR BEREN CORPORATION OPERATOR OF THE KELTON "A" LEASE, AND IS DULY AUTHORIZED TO MAKE THIS AFFIDAVIT FOR AND ON BEHALF OF SAID OPERATOR, THAT WELL NO. 1 ON SAID LEASE HAS BEEN COMPLETED AS OF THE 22nd DAY OF DECEMBER 19 81, AND THAT ALL INFORMATION ENTERED HEREIN WITH RESPECT TO SAID WELL IS TRUE AND CORRECT.

FURTHER AFFIANT SAITH NOT.

(S) *Don W. Beauchamp*

SUBSCRIBED AND SWORN TO BEFORE ME THIS 8th DAY OF JANUARY 19 82

*Karen G. Berry*  
 NOTARY PUBLIC

MY COMMISSION EXPIRES: Nov. 4, 1984

