

This form shall be filed in duplicate with the Kansas Corporation Commission, 200 Colorado Derby Building, Wichita, Kansas 67202, within ten days after the completion of the well, regardless of how the well was completed.

X Attach separate letter of request if the information is to be held confidential. If confidential, only file one copy. Information on side one will be of public record and side two will then be held confidential.

Circle one: Oil, Gas, Dry, SWD, OWWO, Injection. Type and complete ALL sections.

Applications must be filed for dual completion, commingling, SWD and injection, T.A.

X Attach wireline logs (i.e. electrical log, sonic log, gamma ray neutron log, etc.).

KCC # (316) 263-3238. (Rules 82-2-105 & 82-2-125)

OPERATOR Texas Energies, Inc.

API NO. 15-185-21,488-0000

ADDRESS P.O. Box 947

COUNTY Stafford

Pratt, KS 67124

FIELD Wildcat BONHAM SW

**CONTACT PERSON E. H. Bittner

PROD. FORMATION Viola

PHONE (316) 672-7514

LEASE Clark

PURCHASER Koch Oil

WELL NO. 1-33

ADDRESS Box 2256

WELL LOCATION C SW NW

Wichita, KS 67201

660 Ft. from South Line and

DRILLING Texplor

660 Ft. from West Line of

CONTRACTOR

ADDRESS P.O. Box 947

RECEIVED STATE CORPORATION COMMISSION

the NW/4 SEC. 33 TWP. 25s RGE. 12w

Pratt, KS 67124

FEB 10 1982


PLUGGING N/A

CONTRACTOR

ADDRESS

CONSERVATION DIVISION Wichita, Kansas

WELL FLAT

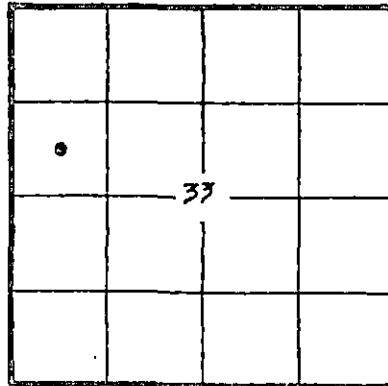

KCC [check] KGS [check] (Office Use)

TOTAL DEPTH 4270 PBD 4242

SPUD DATE 12-05-81 DATE COMPLETED 12-20-81

ELEV: GR 1869 DF 1879 KB 1881

DRILLED WITH (CABLE) (ROTARY) (AIR) TOOLS

Amount of surface pipe set and cemented 414 DV Tool Used? NO

A F F I D A V I T

STATE OF Kansas, COUNTY OF Pratt SS, I,

E. H. Bittner OF LAWFUL AGE, BEING FIRST DULY SWORN UPON HIS OATH,

DEPOSES THAT HE IS Vice-President (FOR)(OF) Texas Energies, Inc.

OPERATOR OF THE Clark LEASE, AND IS DULY AUTHORIZED TO MAKE

THIS AFFIDAVIT FOR AND ON THE BEHALF OF SAID OPERATOR, THAT WELL NO. 1-33 ON


SAID LEASE HAS BEEN COMPLETED AS OF THE 9th DAY OF February, 19 82, AND THAT

ALL INFORMATION ENTERED HEREIN WITH RESPECT TO SAID WELL IS TRUE AND CORRECT.

FURTHER AFFIANT SAITH NOT.

(S) E. H. Bittner

SUBSCRIBED AND SWORN BEFORE ME THIS 9th day of February, 19 82

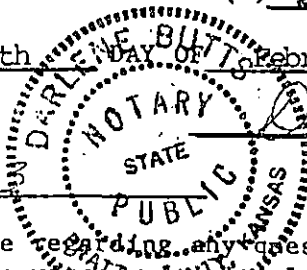

MY COMMISSION EXPIRES: April 23 1983

NOTARY PUBLIC

**The person who can be reached by phone regarding any questions concerning this information. Within 45 days of completion, a witness or initial test by the Commission is required if the well produces more than 25 BOPD or is located in a Basic Order Pool.