

STATE OF KANSAS
STATE CORPORATION COMMISSION


Form CP-4

Give All Information Completely
Make Required Affidavit
Mail or Deliver Report to:
Conservation Division
State Corporation Commission
212 No. Market
Wichita, Kansas 67202

WELL PLUGGING RECORD

FORD County, Sec. 11 Twp. 27S Rge. (E)22 (W)

Location as "NE/CNW%SW%" or footage from lines NW NW NW
Lease Owner J. MARK RICHARDSON
Lease Name NETTIE DEAN Well No. 1
Office Address 200 O. W. GARVEY BUILDING, WICHITA, KANSAS
Character of Well (completed as Oil, Gas or Dry Hole) DRY HOLE
Date well completed 5/19 - 19 73
Application for plugging filed 5/19 19 73
Application for plugging approved 5/19 19 73
Plugging commenced 5/19 19 73
Plugging completed 5/19 19 73
Reason for abandonment of well or producing formation DRY HOLE

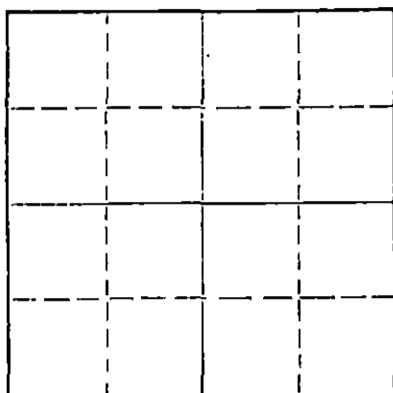

Locate well correctly on above Section Plat

If a producing well is abandoned, date of last production 19
Was permission obtained from the Conservation Division or its agents before plugging was commenced? YES

Name of Conservation Agent who supervised plugging of this well EDGAR EVES
Producing formation _____ Depth to top _____ Bottom _____ Total Depth of Well 5070 Feet
Show depth and thickness of all water, oil and gas formations.

OIL, GAS OR WATER RECORDS

CASING RECORD

FORMATION	CONTENT	FROM	TO	SIZE	PUT IN	PULLED OUT
Surface clay, shale, sand and shale		0	511	8 5/8	511	none

Describe in detail the manner in which the well was plugged, indicating where the mud fluid was placed and the method or methods used in introducing it into the hole. If cement or other plugs were used, state the character of same and depth placed, from _____ feet to _____ feet for each plug set.

Plug of 35 sx cement @ 511'
Plug and bridge to hole Kelly @ 40'
Plugged and abandoned at 3 PM 3/19/73

RECEIVED
STATE CORPORATION COMMISSION
MAY 23 1973
CONSERVATION DIVISION
Wichita, Kansas


(If additional description is necessary, use BACK of this sheet)

Name of Plugging Contractor GABBERT-JONES, INC.
Address 830 Sutton Place, Wichita, Kansas 67202

STATE OF KANSAS, COUNTY OF SEDGWICK, ss.
GABBERT-JONES, INC. (employee of owner) or (owner/operator) of the above-described well, being first duly sworn on oath, says: That I have knowledge of the facts, statements, and matters herein contained and the log of the above-described well as filed, and that the same are true and correct. So help me God.

(Signature) Jack W. Gabbert, 830 Sutton Place, Wichita, Ks

(Address) _____, 19 73

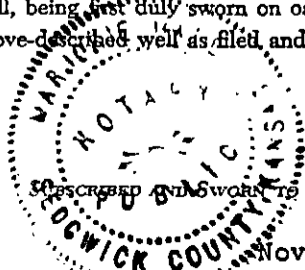

Subscribed and sworn to before me this 22 day of May, 19 73

Marjorie Hall
Notary Public.

GABBERT-JONES, INC.
 WICHITA, KANSAS
 DRILLERS' WELL LOG

NETTIE DEAN #1
 NW NW NW, Section 11-27S-22W
 Ford County, Kansas


Commenced: May 5, 1973
 Completed: May 19, 1973

OPERATOR: J. MARK RICHARDSON

Depth		Formation	Remarks
From	To		
0	240	Surface clay-shale	Ran 13 jts of new 20# 8 5/8" csg, set @ 511' cemented w/375 sks of common
240	533	Sand-shale	3% CC, 2% Gel
533	1265	Shale-redbed	P.D. @ 10:30 PM 5/5/1973 Cement Circ.
1265	1466	Shale	
1466	1486	Anhydrite	
1486	1745	Shale & salt	
1745	2096	Shale-salt-shells	
2096	2470	Shale-lime stks	
2470	2525	Lime-shale	
2525	2555	Lime w/stks Anhydrite	
2555	2760	Lime	
2760	2885	Lime w/skts chert	
2885	3010	Lime	
3010	3300	Shale-lime	
3300	3656	Lime-shale	
3656	3690	Shale-lime	
3690	3785	Lime	
3785	4010	Lime w/chalk stks	
4010	5030	Lime	
5030	5070	Lime-Dolomite	
5070	TD		DRY AND ABANDONED

RECEIVED
 STATE CORPORATION COMMISSION
 MAY 23 1973
 CONSERVATION DIVISION
 Wichita, Kansas

I, James S. Sutton, II, certify this is a correct copy of the Drillers' Log for the well drilled in the NW NW NW, Section 11-27S-22W, Fort County, Kansas, to the best of my knowledge and belief.


 James S. Sutton, II

STATE OF KANSAS)
) SS
 COUNTY OF SEDGWICK)

Before me, the undersigned, a Notary Public within and for said County and State, on this 21st day of May, 1973, personally appeared James S. Sutton, II, to me personally known to be the identical person who executed the within and foregoing instrument and acknowledged to me that he executed the same as his free and voluntary act and deed for the uses and purposes therein set forth.

IN WITNESS WHEREOF, I have hereunto set my hand and official seal the day and year last above written.


 Marjorie Hall, Notary Public

