


Give All Information Completely
Make Required Affidavit
Mail or Deliver Report to:
Conservation Division
State Corporation Commission
212 No. Market
Wichita, Kansas

WELL PLUGGING RECORD

Kiowa County, Sec. 35 Twp 27S Rge. (E) 20 (W)
660' FSL & 1980 FEL

Location as "NE/CNW/SW" or footage from lines
Lease Owner Anadarko Production Company
Lease Name Sherer "C" #1 Well No. #1
Office Address Box 351, Liberal, Kansas 67901
Character of Well (completed as Oil, Gas or Dry Hole) Dry Hole
Date well completed 1-3 19 75
Application for plugging filed 12-6 19 74
Application for plugging approved 12-9 19 74
Plugging commenced 1-3 19 75
Plugging completed 1-3 19 75
Reason for abandonment of well or producing formation Dry Hole

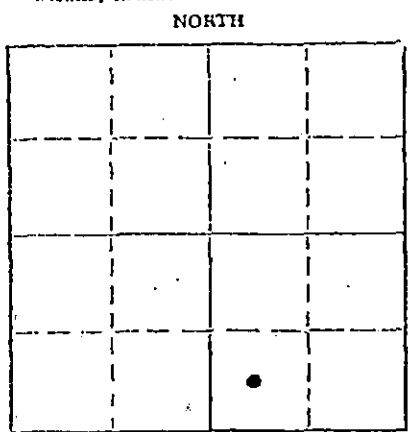

Locate well correctly on above Section Plot

If a producing well is abandoned, date of last production _____ 19____
Was permission obtained from the Conservation Division or its agents before plugging was commenced? Yes

Name of Conservation Agent who supervised plugging of this well G. Russell Biberstein
Producing formation _____ Depth to top _____ Bottom _____ Total Depth of Well 4910 Feet
Show depth and thickness of all water, oil and gas formations.

OIL, GAS OR WATER RECORDS

CASING RECORD

FORMATION	CONTENT	FROM	TO	SIZE	PUT IN	PULLED OUT
				8-5/8"	311	None
				4-1/2"	4908	3428
				2-3/8"	4985	None

Describe in detail the manner in which the well was plugged, indicating where the mud fluid was placed and the method or methods used in introducing it into the hole. If cement or other plugs were used, state the character of same and depth placed, from _____ feet to _____ feet for each plug set.

Pumped plug to 4700'. Shot 4-1/2" csg @ 4083', 3820', 3617', 3428', csg free @ 3428'. Spotted 100 sacks Common @ 450'-0'. Completed 4 p.m. 1/3/75.

RECEIVED
STATE CORPORATION COMMISSION

JAN 8 1975

CONSERVATION DIVISION
Wichita, Kansas


(If additional description is necessary, use BACK of this sheet)
Name of Plugging Contractor Sargent's Casing Pulling Service
Address Box 506, Liberal, Kansas 67901

STATE OF Kansas COUNTY OF Seward, ss.
T. W. Williams (employee of owner) or (owner or operator) of the above-described well, being first duly sworn on oath, says: That I have knowledge of the facts, statements, and matters herein contained and the log of the above-described well as filed and that the same are true and correct. So help me God!

(Signature) T. W. Williams
T. W. Williams
Box 351, Liberal, Kansas 67901
(Address)

SUBSCRIBED AND SWORN TO before me this 7th day of January, 19 75

My commission expires _____

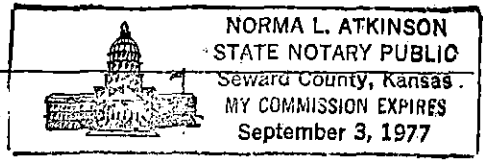

Norma L. Atkinson
Notary Public.

KANSAS DRILLERS LOG

S. 35 T. 27 R. 20W^E/_W

API No. 15 — 097 — 20,247
County Number

Loc. C SW SE


Operator
Anadarko Production Co.

County Kiowa

Address
Box 351, Liberal, Kansas 67901

640 Acres
 N

Well No. 1 Lease Name Sherer "C"

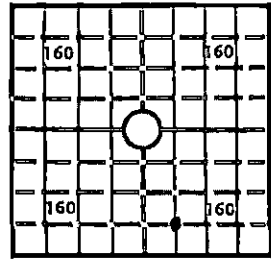

Footage Location
660 feet from (S) line 1980 feet from (E) line

Elev.: Gr. 2296'

Principal Contractor Gabbert-Jones, Inc. Geologist Jay Dirks

Spud Date 7-24-74 Total Depth 4910' P.B.T.D.

Date Completed Oil Purchaser

DF _____ KB _____

CASING RECORD

Report of all strings set— surface, intermediate, production, etc.

Purpose of string	Size hole drilled	Size casing set (in O.D.)	Weight lbs/ft.	Setting depth	Type cement	Sacks	Type and percent additives
Surface	12-1/4"	8-5/8"	18#	311	Common	300	3% CC
Production	7-7/8"	4-1/2"	10.5#	4908	Pozmix	140	.5% CFR-2

RECEIVED
 STATE CORPORATION COMMISSION
 DEC 6 1974
 CONSERVATION DIVISION
 WICHITA, KANSAS
 2 - SPF

LINER RECORD

Top, ft.	Bottom, ft.	Sacks cement

PERFORATION RECORD

Shots per ft.	Size & type	Depth interval
2 - SPF		4880' - 96'
2 - SPF		4869' - 76'

TUBING RECORD

Size	Setting depth	Packer set at
2-3/8"	4985'	

ACID, FRACTURE, SHOT, CEMENT SQUEEZE RECORD

Amount and kind of material used	Depth interval treated
Acidized w/800 gallons Mod 202	4880' - 86'
Acidized w/800 gallons Mod 202	4869' - 76'

INITIAL PRODUCTION

Date of first production <u>Dry Hole</u>		Producing method (flowing, pumping, gas lift, etc.)			
RATE OF PRODUCTION PER 24 HOURS	Oil bbls.	Gas MCF	Water bbls.	Gas-oil ratio CFPB	
Disposition of gas (vented, used on lease or sold)			Producing interval(s)		

INSTRUCTIONS: As provided in KCC Rule 82-2-125, within 90 days after completion of a well, one completed copy of this Drillers Log shall be transmitted to the State Geological Survey of Kansas, 4150 Monroe Street, Wichita, Kansas 67209. Copies of this form are available from the Conservation Division, State Corporation Commission, 3830 So. Meridian (P.O. Box 17027), Wichita, Kansas 66217. Phone AC 316-522-2206. If confidential custody is desired, please note Rule 82-2-125. Drillers Logs will be on open file in the Oil and Gas Division, State Geological Survey of Kansas, Lawrence, Kansas 66044.

Operator
Anadarko Production Company

DESIGNATE TYPE OF COMP.: OIL, GAS,
DRY HOLE, SWDW, ETC.:
Dry Hole

Well No. #1
Lease Name Sherer "C"

s35 T 27SR20 K W

WELL LOG

Show all important zones of porosity and contents thereof; cored intervals, and all drill-stem tests, including depth interval tested, cushion used, time tool open, flowing and shut-in pressures, and recoveries.

SHOW GEOLOGICAL MARKERS, LOGS RUN, OR OTHER DESCRIPTIVE INFORMATION.

FORMATION DESCRIPTION, CONTENTS, ETC.	TOP	BOTTOM	NAME	DEPTH
Surface-Sand & Clay	0	314		
Shale	314	714		
Shale-Anhy	714	1545		
Shale-Lime	1545	1985		
Lime-Shale	1985	4338		
Lime	4338	4364		
Lime-Shale	4364	4543		
Lime	4543	4910		
Total Depth		4910		

USE ADDITIONAL SHEETS, IF NECESSARY, TO COMPLETE WELL RECORD.

Date Received



T. W. Williams

Signature

December 6, 1974

Date

Division Office Supervisor

Title