


STATE OF KANSAS
STATE CORPORATION COMMISSION

Give All Information Completely
Make Required Affidavit
Mail or Deliver Report to:
Conservation Division
State Corporation Commission
P. O. Box 17027
Wichita, Kansas 67217
NORTH

WELL PLUGGING RECORD

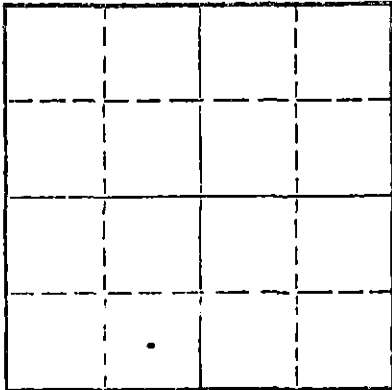

Locate well correctly on above
Section Plat

KIOWA County, Sec. 35 Twp. 27s Rge. 20 (EX) (W)
Location as "NE/CNWXSW" or footage from lines C SE SW
Lease Owner PETROLEUM, INC.,
Lease Name MCFADDEN 'C' Well No. 1
Office Address BOX 1447, GREAT BEND, KANSAS
Character of Well (completed as Oil, Gas or Dry Hole) OIL WELL
Date well completed FEBRUARY 13 19 76
Application for plugging filed FEBRUARY 25 19 77
Application for plugging approved MARCH 2 19 77
Plugging commenced APRIL 7 19 77
Plugging completed APRIL 19 19 77
Reason for abandonment of well or producing formation DEPLETION OF PRODUCING ZONE
If a producing well is abandoned, date of last production FEBRUARY 22 19 77
Was permission obtained from the Conservation Division or its agents before plugging was commenced? YES

Name of Conservation Agent who supervised plugging of this well J. METZ
Producing formation _____ Depth to top _____ Bottom _____ Total Depth of Well _____ Feet
Show depth and thickness of all water, oil and gas formations.

OIL, GAS OR WATER RECORDS

CASING RECORD

FORMATION	CONTENT	FROM	TO	SIZE	PUT IN	PULLED OUT
MISSISSIPPI	SMALL AMOUNT OF WATER & OIL			8-5/8"	616'	NONE
				5-1/2"	4897'	3804'

Describe in detail the manner in which the well was plugged, indicating where the mud fluid was placed and the method or methods used in introducing it into the hole. If cement or other plugs were used, state the character of same and depth placed, from _____ feet to _____ feet for each plug set.

SANDED BACK TO 4800' AND DUMPED 5 SACKS CEMENT. SUN OILWELL CEMENTING COMPANY PLUGGED WELL WITH PUMPING 3 SACKS COTTON SEED HULLS, 15 SACKS OF GEL AND 100 SACKS CEMENT TO BASE OF WELL CELLAR.

RECEIVED
STATE CORPORATION COMMISSION

APR 29 1977

CONSERVATION DIVISION
Wichita, Kansas

(If additional description is necessary, use BACK of this sheet)
Name of Plugging Contractor PIPE PULLERS, INC.,
Address BOX 128, ELLINWOOD, KANSAS 67526

STATE OF KANSAS, COUNTY OF BARTON, ss.
MONTE CHADD (employee of owner) or (owner or operator) of the above-described well, being first duly sworn on oath, says: That I have knowledge of the facts, statements, and matters herein contained and the log of the above-described well as filed and that the same are true and correct. So help me God.

(Signature) Monte Chadd
MONTE CHADD, DIST. PROD. SUPT.
(Address)



Subscribed and sworn to before me this 28 day of APRIL, 19 77.
Richard H. Dumber
Notary Public.

WELL LOG

COMPANY Petroleum, Inc.

SEC. 35 T. 27S R. 20W

FARM McFadden "C"

NO. 1

LOC. SE SW

TOTAL DEPTH 4898'


COUNTY Kiowa

COMM. 1-11-76

COMP. 1-25-76

CONTRACTOR DaMac Drilling Company, Inc.

CASING 8 5/8 set @ 616

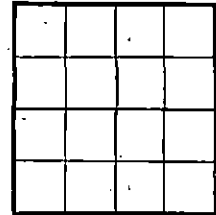

ELEVATION

PRODUCTION

FIGURES INDICATE BOTTOM OF FORMATIONS

0	616	Red Bed
616	635	Red Bed & Shale
635	1665	Shale
1665	4165	Lime & Shale
4165	4893	Lime
4893	4898	Miss.
	4898	RTD

RECEIVED
STATE CORPORATION COMMISSION

APR 29 1977

CONSERVATION DIVISION
Wichita, Kansas

State of Kansas }
County of Barton } ss

I, Martha J. McKown of DaMac Drilling Company, Inc.

upon oath state the above and foregoing is a true and correct copy of the log of the McFadden "C" well.

DONALD SLOUP
STATE NOTARY PUBLIC
Barton County, Kansas
My Commission Expires
November 11, 1978

Martha J. McKown

Subscribed and sworn to before me this 26th day of January 19 76

My Commission Expires: 11-11-78

DONALD SLOUP
STATE NOTARY PUBLIC
Barton County, Kansas
My Commission Expires
November 11, 1978

Donald Sloup
NOTARY PUBLIC