


STATE OF KANSAS
STATE CORPORATION COMMISSION

WELL PLUGGING RECORD

Give All Information Completely
Make Required Affidavit
Mail or Deliver Report to:
Conservation Division
State Corporation Commission
212 No. Market
Wichita, Kansas

NORTH

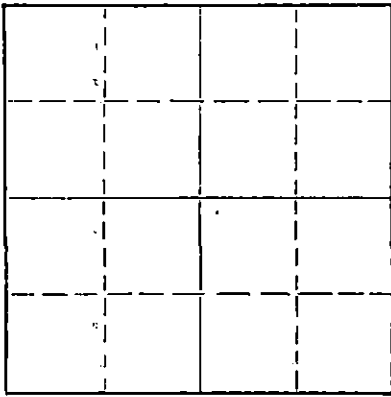

Locate well correctly on above
Section Plat

Pratt County, Sec. 36 Twp. 27S Rge. (E) 12 (W)
Location as "NE/CNW/SW" or footage from lines S/2 NW NW
Lease Owner Barnett Oil Company
Lease Name Bergner Well No. 1
Office Address 411 First Ntl Bldg., Wichita, Kansas 67202
Character of Well (completed as Oil, Gas or Dry Hole) Dry Hole
Date well completed 10-2 19 68
Application for plugging filed 10-2 19 68
Application for plugging approved 10-2 19 68
Plugging commenced 10-2 19 68
Plugging completed 10-2 19 68
Reason for abandonment of well or producing formation Dry Hole

If a producing well is abandoned, date of last production 19
Was permission obtained from the Conservation Division or its agents before plugging was commenced? Yes

Name of Conservation Agent who supervised plugging of this well Ralph Warren
Producing formation Depth to top Bottom Total Depth of Well 4120 Feet
Show depth and thickness of all water, oil and gas formations.

OIL, GAS OR WATER RECORDS

CASING RECORD

FORMATION	CONTENT	FROM	TO	SIZE	PUT IN	PULLED OUT
				8 5/8"	830.50'	

Describe in detail the manner in which the well was plugged, indicating where the mud fluid was placed and the method or methods used in introducing it into the hole. If cement or other plugs were used, state the character of same and depth placed, from feet to feet for each plug set.

Plugged @ 300' with 60 sacks cement - Plugged @ 50' with 40 sacks cement - 5 sacks cement in rat hole

RECEIVED
STATE CORPORATION COMMISSION
OCT 8 - 1968
CONSERVATION DIVISION
Wichita, Kansas

(If additional description is necessary, use BACK of this sheet)

Name of Plugging Contractor Leben Drilling, Inc.
Address Box 486, Great Bend, Kansas

STATE OF KANSAS, COUNTY OF BARTON, ss.
Leslie Kite

(employee of owner) or (owner or operator) of the above-described well, being first duly sworn on oath, says: That I have knowledge of the facts, statements, and matters herein contained and the log of the above-described well as filed and that the same are true and correct. So help me God.

(Signature) Leslie Kite

SUBSCRIBED AND SWORN TO before me this 7th day of October 19 68

My commission expires April 1, 1971

Ulanda Nichols

Notary Public.

DRILLER'S LOG

COMPANY
CONTRACTOR
FARM
LOCATION

Barnett Oil Company
LEBEN DRILLING, INC.
BERGNER #1
S/2 NW NW SECTION 36-27S-12W
PRATT COUNTY, KANSAS
9-23-68
10-2-68

COMMENCED
COMPLETED

0	22	Clay
22	118	Sand
118	831	Red Bed
831	1485	Shale
1485	1832	Shale, Lime
1832	2085	Lime
2085	2775	Shale, Lime
2775	3010	Lime, Shale
3010	3600	Shale, Lime
3600	4120	Lime
	<u>4120</u>	<u>RTD - D. & A.</u>

8 5/8" 32# used surface casing set @ 830.50' cemented with 300 sacks Pozmix HA5, 4% gel, 200 sacks Pozmix HA5

I, Leslie Kite, do hereby certify that the above and foregoing is a true and correct copy of the log of the Bergner #1 Well, located S/2 NW NW of Section 36, Township 27 South, Range 12 West, Pratt County, Kansas, as reflected by the records of Leben Drilling, Inc.

Leslie Kite
Leslie Kite

STATE OF KANSAS)
COUNTY OF BARTON) SS

RECEIVED
STATE CORPORATION COMMISSION
OCT 8 - 1968
CONSERVATION DIVISION
Wichita, Kansas

Subscribed and sworn to and before me, a Notary Public, in and for Barton County, Kansas, this 7th day of October, 1968.

Ulanda Nichols
Ulanda Nichols

My Commission Expires:
April 1, 1971