


Give All Information Completely
Make Required Affidavit
Mail or Deliver Report to:
Conservation Division
State Corporation Commission
211 No. Broadway
Wichita, Kansas

NORTH

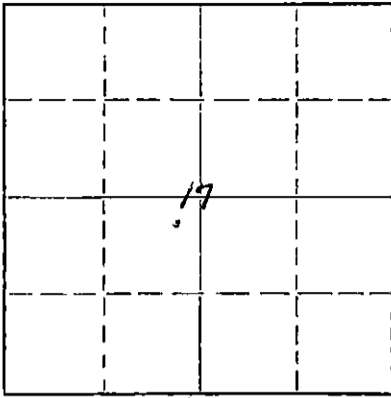

Locate well correctly on above
Section Plat

Pratt County. Sec. 17 Twp. 27S Rge. 12 (E) 12 (W)
Location as "NE/CNW%SW%" or footage from lines Ctr. NE 1/4 NE 1/4 SW 1/4
Lease Owner Monsanto Chemical Company (Lion Oil Company Division)
Lease Name Hoeme Well No. 2
Office Address P. O. Box 580, Pratt, Kansas
Character of Well (completed as Oil, Gas or Dry Hole) Dry Hole
Date well completed August 5, 19 57
Application for plugging filed August 5, 19 57
Application for plugging approved (Verbal) August 5, 19 57
Plugging commenced August 5, 19 57
Plugging completed August 5, 19 57
Reason for abandonment of well or producing formation Dry Hole

If a producing well is abandoned, date of last production 19
Was permission obtained from the Conservation Division or its agents before plugging was commenced? Yes

Name of Conservation Agent who supervised plugging of this well R. M. Brundege
Producing formation None Depth to top Bottom Total Depth of Well 4425 Feet
Show depth and thickness of all water, oil and gas formations.

OIL, GAS OR WATER RECORDS

CASING RECORD

FORMATION	CONTENT	FROM	TO	SIZE	PUT IN	PULLED OUT
				8-5/8"	310'	None

Describe in detail the manner in which the well was plugged, indicating where the mud fluid was placed and the method or methods used in introducing it into the hole. If cement or other plugs were used, state the character of same and depth placed, from feet to feet for each plug set.

Plugged with heavy mud from 4425' to 310', Halliburton plug at 310' with 1/3 sack of hulls and 20 sacks of cement. Heavy mud to 35' and Halliburton plug at 35' with 1/3 sack of hulls and 10 sacks of cement on top of plug. Cement to base of cellar.

(If additional description is necessary, use BACK of this sheet)

Name of Plugging Contractor Lauck Drilling Company
Address 301 South Broadway, Wichita, Kansas

STATE OF KANSAS, COUNTY OF PRATT, ss.
Bruce E. Roll (employee of owner) or (owner or operator) of the above-described well, being first duly sworn on oath, says: That I have knowledge of the facts, statements, and matters herein contained and the log of the above-described well as filed and that the same are true and correct. So help me God.

(Signature) Bruce E. Roll
P. O. Box 580, Pratt, Kansas
(Address)

SUBSCRIBED AND SWORN TO before me this 6th day of August, 19 57

My commission expires September 19, 1959

M. J. Lamb RECEIVED
STATE C... Notary Public.

PLUGGING
FILE SEC. 17 T. 27 R. 12W
BOOK PAGE 34 LINE 5

8-7-57 AUG 7 1957

CONSERVATION DIVISION
Wichita, Kansas

Comp. Log

15-151-10221-0000

Monsanto Chemical Company
Lion Oil Company Division

Hoome #2

NE NE SW Sec.17- 27S-12W
Pratt County Kansas

Commenced: July 18, 1957
Completed: Aug. 5, 1957

Rotary Drilling Contractor: Lauck Drilling Company, Inc.

Casing Record: 319' @ 5/8" cen.w/240 sx

Elevation: GR 1852; DF 1855; RD 1857;

Drillers Log

Sand	0 - 100
shale	100 - 319
red bed	319 - 620
shale & red bed	620 - 1050
shale, shells & sand	1050 - 1250
shale & shells	1250 - 1725
Lime & shale	1725 - 3310
Lime	3310 - 3440
Lime & shale	3440 - 3555
Douglas Lime	3555 - 3645
Lime	3645 - 4080
Lime & shale	4080 - 4118
chert	4118 - 4122
Lime & shale	4122 - 4172
chert & lime	4172 - 4184
Dolomite	4184 - 4192
Lime	4192 - 4300
chert lime	4300 - 4339
lime	4339 - 4369
sand	4369 - 4376
lime	4376 - 4384
sand	4384 - 4399
shale	4399 - 4425

RTD

RECEIVED
STATE OF KANSAS
COMMISSION

OCT 1 - 1957

OSG ELEVATION DIVISION
Wichita, Kansas

Wichita, Kansas
Aug. 26 1957

I hereby certify that the above is a true and correct log of the No.2 Hoome well, to the best of my knowledge and belief.

John H. Knightley
John H. Knightley

Subscribed and sworn to before me this 26th day of August, 1957

Elizabeth Gay
Notary Public

My commission expires Sept.14, 1959

PLUGGING
FILE SEC.17 T.27 R.12W
BOOK PAGE 34 LINE 5