

STATE OF KANSAS
STATE CORPORATION COMMISSION

Form CP-4


WELL PLUGGING RECORD

Give All Information Completely
Make Required Affidavit
Mail or Deliver Report to:
Conservation Division
State Corporation Commission
211 No. Broadway
Wichita, Kansas

Pratt County. Sec. 6 Twp. 27 Rge. 12 (E) (W)

Location as "NE/CNW/SW" or footage from lines. NE NW NW
Lease Owner Terra Resources, Inc.
Lease Name McFadden "C" Well No. 7
Office Address Drawer C, Great Bend, Ks. 67530
Character of Well (completed as Oil, Gas or Dry Hole) Oil
Date well completed 2-18 19 53
Application for plugging filed 4-24 19 74
Application for plugging approved 4-25 19 74
Plugging commenced 5-31 19 74
Plugging completed 6-3 19 74
Reason for abandonment of well or producing formation Uneconomical

NORTH

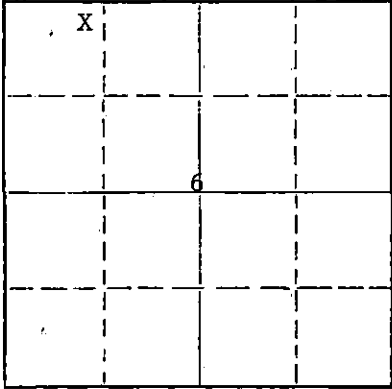

Locate well correctly on above Section Plat

If a producing well is abandoned, date of last production 4-25 19 68
Was permission obtained from the Conservation Division or its agents before plugging was commenced? Yes

Name of Conservation Agent who supervised plugging of this well G. R. Biberstein
Producing formation Simpson Depth to top 3709 Bottom 4042 Total Depth of Well 4281 Feet
Show depth and thickness of all water, oil and gas formations.

OIL, GAS OR WATER RECORDS

CASING RECORD

FORMATION	CONTENT	FROM	TO	SIZE	PUT IN	PULLED OUT
				8 5/8	470	0
				5 1/2	4281	2418

Describe in detail the manner in which the well was plugged, indicating where the mud fluid was placed and the method or methods used in introducing it into the hole. If cement or other plugs were used, state the character of same and depth placed, from _____ feet to _____ feet for each plug set.

Spotted 1 bbl fresh water on sand bridge at 4254'. Dumped 4 sacks cement on bottom with bailer. Top of bottom plug at 4231'. Shot pipe at 2416'. Spotted 26 sacks mud. Pulled pipe to 404' and circulated to surface with 150 sacks cement. Pulled freed casing and filled hole with cement to surface. Two days later ran bailer to 155'. Dumped 2 1/2 yards Ready-mix cement and filled casing to surface. Cut casing off 3' below ground level and capped. Plugging complete.

RECEIVED
STATE CORPORATION COMMISSION
JUN 14 1974
CONSERVATION DIVISION
Wichita, Kansas

(If additional description is necessary, use BACK of this sheet)

Name of Plugging Contractor Kincaid Well Servicing Co.
Address Box 276, Ellinwood, Ks.

STATE OF Kansas, COUNTY OF Barton, ss. C. E. McCartney (employee of owner) or (owner or operator)

well, being first duly sworn on oath, says: That I have knowledge of the facts, statements, and matters herein contained and the log of the above-described well as filed and that the same are true and correct. So help me God.

(Signature) C. E. McCartney
Drawer C, Great Bend, Ks. 67530 (Address)

SUBSCRIBED AND SWORN TO before me this 11th day of June 19 74

My commission expires 12-7-76

LEROY DIETZ
STATE NOTARY PUBLIC
Barton County, Kansas
My Comm. Expires Dec. 7, 1978
Notary Public.

DRILLERS LOG

McFadden "C" #7

Elevation: 1907' D.F.
 Casings: 8 5/8" @ 1470' w/ 300 ft.
 5 1/2" @ 1281' w/ 150 ft.

Loc: NE-11N-11W
 Sec: 6-27S-12W
 Pratt County, Kansas
 Operator: Cooperative Refinery Ass'n.
 Contractor: Balms Drilling Company

Comm: 2-1-53 Comp: 2-13-53
 Total Depth: 1281'

From	To	Formation
0	170	Sand
170	470	Red Bed & Shells
470	520	Cement & Shale
520	760	Red Bed & Shale
760	800	Anhydrite
800	1100	Shale & Shells
1100	1250	Salt
1250	1730	Shale & Shells
1730	2220	Lime
2220	2710	Lime & Shale
2710	2845	Shale
2845	2955	Lime & Shale
2955	3045	Lime
3045	3185	Shale
3185	3340	Lime
3340	3435	Lime & Shale
3435	3440	Shale
3440	3510	Lime & Sand
3510	3564	Lime
3564	3695	Sand, Shale
3695	4075	Lime
4075	4110	Cherty Lime
4110	4152	Lime & Chert
4152	4156	Chert
4156	4175	Shale & Chert
4175	4213	Chert
4213	4229	Shale
4229	4281	Shale
4281		R.T.D.

RECEIVED
 STATE CORPORATION COMMISSION
 APR 25 1974
 CONSERVATION DIVISION
 Wichita, Kansas

(STATE OF KANSAS)
 (COUNTY OF BARTON)

I hereby certify that the above is a true and correct copy of the log on the
 McFadden "C" #7 well, located NE-11N-11W of Section 6-27S-12W, Pratt County, Kansas.

L. M. Collins

Subscribed and sworn to before me this 26 day of March 1953.

Clyde E. Endicott

My commission expires: 2-20-57