


STATE OF KANSAS  
STATE CORPORATION COMMISSION

15-155-30116-0000 Form CP-4

Give All Information Completely  
Make Required Affidavit  
Mail or Deliver Report to:  
Conservation Division  
State Corporation Commission  
212 No. Market  
Wichita, Kansas 67202

WELL PLUGGING RECORD

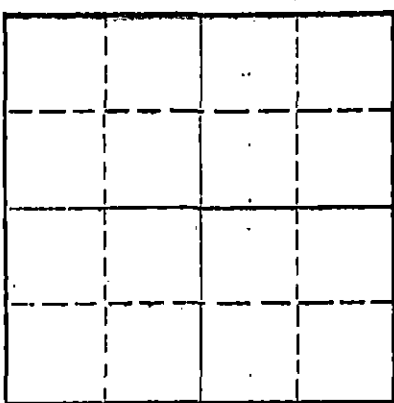

Locate well correctly on above Section Plot

Range 24 County W Sec. 26 Twp. 9 Rge. (E) (W)  
Location as "NE/CNW/SW" or footage from lines C NE/4  
Lease Owner Robert F. White  
Lease Name Clough Jones #1 Well No. \_\_\_\_\_  
Office Address Wichita, Kansas 67202  
Character of Well (completed as Oil, Gas or Dry Hole) \_\_\_\_\_  
Date well completed \_\_\_\_\_ 19\_\_\_\_  
Application for plugging filed \_\_\_\_\_ 19\_\_\_\_  
Application for plugging approved \_\_\_\_\_ 19\_\_\_\_  
Plugging commenced 2/3/71 \_\_\_\_\_ 19\_\_\_\_  
Plugging completed 2/10/71 \_\_\_\_\_ 19\_\_\_\_  
Reason for abandonment of well or producing formation depleted.

If a producing well is abandoned, date of last production \_\_\_\_\_ 19\_\_\_\_  
Was permission obtained from the Conservation Division or its agents before plugging was commenced? yes

Name of Conservation Agent who supervised plugging of this well Toman  
Producing formation \_\_\_\_\_ Depth to top \_\_\_\_\_ Bottom \_\_\_\_\_ Total Depth of Well 2462 Feet  
Show depth and thickness of all water, oil and gas formations.

OIL, GAS OR WATER RECORDS

CASING RECORD

| FORMATION | CONTENT | FROM | TO | SIZE   | PUT IN | PULLED OUT |
|-----------|---------|------|----|--------|--------|------------|
|           |         |      |    | 8-5/8  | 307    | none       |
|           |         |      |    | 4 1/2" | 2462   | 1495'      |
|           |         |      |    |        |        |            |
|           |         |      |    |        |        |            |
Describe in detail the manner in which the well was plugged, indicating where the mud fluid was placed and the method or methods used in introducing it into the hole. If cement or other plugs were used, state the character of same and depth placed, from \_\_\_\_\_ feet to \_\_\_\_\_ feet for each plug set.

Killed well with water, took tubing out and put sub in well.  
Checked hole to 2462', got water truck to kill gas, set plug at 1995', ran sand to 1950' and set 3 sacks of cement. Shot pipe at 1907', 1590', 1500', got loose and pulled 47 joints.  
Bailed hole to 225', set 10' rock bridge and ran 25 sacks of cement. Mudded hole to 40', set 10' rock bridge and ran 10 sacks of cement on top.

PLUGGING COMPLETE. RECEIVED  
STATE CORPORATION COMMISSION  
MAR 24 1971  
CONSERVATION DIVISION  
Wichita, Kansas

Name of Plugging Contractor KNIGHT CASING PULLING CO., INC.  
Address Chase, Kansas

STATE OF Kansas COUNTY OF Rice ss. Noel J. Knight

(employee of owner) or (owner or operator) of the above-described well, being first duly sworn on oath, says: That I have knowledge of the facts, statements, and matters herein contained and the log of the above-described well as filed and that the same are true and correct. So help me God.

(Signature) Noel J. Knight  
Chase, Kansas  
(Address)

Subscribed and Sworn to before me this 12th day of February, 19 71

My commission expires 2/15/71  
Margaret Malachuk  
Notary Public.