


Give All Information Completely
Make Required Affidavit
Mail or Deliver Report to:
Conservation Division
State Corporation Commission
800 Bittling Building
Wichita, Kansas

WELL PLUGGING RECORD

15-155-00325-0000

NORTH

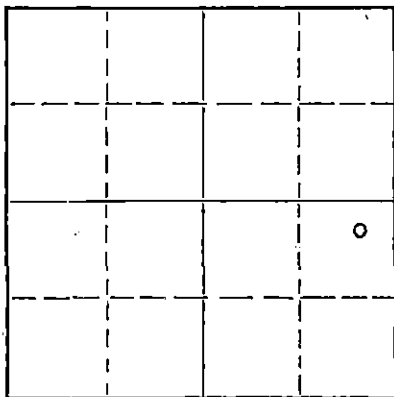

Locate well correctly on above
Section Plat

Reno County, Sec. 26 Twp. 26 Rge. 9 (E) W (W)
Location as "NE/CNW&SW¼" or footage from lines NE NE SE
Lease Owner Harms-Burt Drilling Company
Lease Name Jones Well No. 1
Office Address Box 184, Great Bend, Kansas
Character of Well (completed as Oil, Gas or Dry Hole) Dry Hole
Date well completed November 26 19 54
Application for plugging filed November 26 19 54
Application for plugging approved November 26 (orally) 19 54
Plugging commenced November 26 19 54
Plugging completed November 26 19 54
Reason for abandonment of well or producing formation

If a producing well is abandoned, date of last production 19
Was permission obtained from the Conservation Division or its agents before plugging was commenced? yes

Name of Conservation Agent who supervised plugging of this well M.A. Rives, Pratt, Kansas
Producing formation Depth to top Bottom Total Depth of Well Feet
Show depth and thickness of all water, oil and gas formations.

OIL, GAS OR WATER RECORDS


CASING RECORD

FORMATION	CONTENT	FROM	TD	SIZE	PUT IN	PULLED OUT
Surface		0	210'	8 5/8"	210'	0

Describe in detail the manner in which the well was plugged, indicating where the mud fluid was placed and the method or methods used in introducing it into the hole. If cement or other plugs were used, state the character of same and depth placed, from feet to feet for each plug set.

Filled hole with mud from 4433 TD to 200'.
Set plug at 200' with 20 sacks of cement-on top.
Heavy mud to 35' plug set at 35'
10 sacks of cement on top of plug.

12-11-54

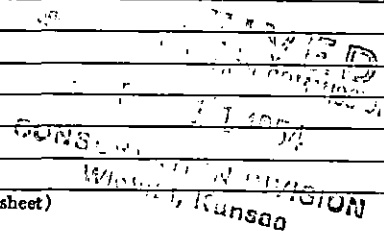

(If additional description is necessary, use BACK of this sheet)
Name of Plugging Contractor Harms-Burt Drilling Co.
Address Box 184, Great Bend, Kansas


STATE OF Kansas, COUNTY OF Barton, ss.
Allan Harms (employee of owner) or (owner or operator) of the above-described well, being first duly sworn on oath, says: That I have knowledge of the facts, statements, and matters herein contained and the log of the above-described well as filed and that the same are true and correct. So help me God.

(Signature) Allan Harms
Box 184, Great Bend, Kans.
(Address)

SUBSCRIBED AND SWORN TO before me this 10 day of December 1954

My commission expires Jan. 20, 1958

Mary E. Van Pelt
Mary E. Van Pelt Notary Public.

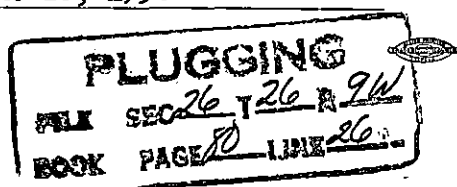

DRILLER'S LOG

15-155-00325-0000

Company: Harms-Burt Drilling Co.

NE NE SE Sec. 26-26S-9W
Reno County, Kansas

Farm: Jones No. 1

Commenced: November 8, 1954

Completed: November 26, 1954 Elevation: 1670 RB

0- 40	Clay	3640-3675	Lime & shale
40- 85	Sand	3675-3740	Lime
85- 210	Red bed	3740-3942	Lime & shale
210- 580	Red bed & shale	3942-3987	Lime & chert
580-1157	Shale & shells	3987-4110	Lime & shale
1157-1178	Anhydrite	4110-4130	shale & shells
1178-1305	Shale & salt	4130-4191	Lime & shale
1305-1360	Anhydrite	4191-4211	Shale & lime
1360-1425	Anhydrite & shale	4211-4221	Chert with lime
1425-1490	Shale & shells	4221-4228	Lime & chert
1490-1695	Lime & shale	4228-4245	Chert
1695-1960	Lime	4245-4288	Chert & lime
1960-2645	Lime & shale	4288-4305	Shale & sand
2645-3160	Lime	4305-4307	Sand
3160-3245	Lime & shale	4307-4376	Shale & sand
3245-3270	Shale & sand	4376-4383	Sand
3270-3345	Shale & lime	4383-4407	Lime
3345-3359	Brown lime & shale	4407-4433	Lime
3359-3640	Lime & cc	4433	R. T.D.

Set 210' of 8 5/8" surface pipe, cemented with 300 sacks common cement and 5 sacks of calcium chloride.

Tops:	Douglas Sand	3254
	Kansas City	3359
	Mississippi	3942
	Simpson	4305
	Arbuckle	4383

Drill Stem Tests:	No. 1.	4209-21	Open 1 hr. shut in 30 min. 115' salt water.
			IFP 14# FFP 54# BHP 1240#
	No. 2.	4287-4305	Open 1 hr. shut in 30 min. 10' mud.
			BHP 0#
	No. 3.	4379-4433	Open 1 hr. shut in 30 min. 3230' salt water.
			IFP 120# FFP 1533# BHP 1653#

Ran Schlumberger Log. Dry, plugged and abandoned.

AFFIDAVIT: State of Kansas)
County of Barton) SS.

I, Allan Harms, of the Harms-Burt Drilling Co., being first duly sworn on oath state: That I have knowledge of the facts, statements, and matters herein contained and that the same are true and correct.

Signed: Allan Harms
Subscribed and sworn to before me this 10 day of December, 1954
My commission expires: 1-20-58

Mary E. Van Pelt
Notary Public

