

WELL PLUGGING RECORD

OR

FORMATION PLUGGING RECORD

Strike out upper line
when reporting plug-
ging of formations.

Give All Information Completely
Make Required Affidavit
Mail or Deliver Report to:
Conservation Division
State Corporation Commission
800 Bitting Building
Wichita, Kansas

Range 28 County. Sec. 26 Twp. 9 Rge. (E) 9 (W)
Location as "NE $\frac{1}{4}$ NW $\frac{1}{4}$ SW $\frac{1}{4}$ " or footage from lines. NE/c NW/4 SE/4
Lease Owner. William Herbert Hunt Trust Estate
Lease Name. Maude Dutton Well No. 1
Office Address. 1107 City Bank Bldg., Shreveport, La.
Character of Well (completed as Oil, Gas or Dry Hole) Dry Hole
Date well completed. 6-30 1948
Application for plugging filed. 6-30 1948
Application for plugging approved. 6-30 1948
Plugging commenced. 7-1 1948
Plugging completed. 19____
Reason for abandonment of well or producing formation. _____
If a producing well is abandoned, date of last production. 19____
Was permission obtained from the Conservation Division or its agents before plugging was com-
menced? Yes

NORTH

Locate well correctly on above
Section Plat

Name of Conservation Agent who supervised plugging of this well. Ruel Durkes
Producing formation. _____ Depth to top. _____ Bottom. _____ Total Depth of Well. _____ Feet
Show depth and thickness of all water, oil and gas formations.

OIL, GAS OR WATER RECORDS

CASING RECORD

Formation	Content	From	To	Size	Put In	Pulled Out
		<u>0</u>	<u>130</u>	<u>8 5/8</u>	<u>6-12-48</u>	

Describe in detail the manner in which the well was plugged, indicating where the mud fluid was placed and the method or methods used in introducing it into the hold. If cement or other plugs were used, state the character of same and depth placed, from _____ feet to _____ feet for each plug set.

Hole filled with heavy mud - wood plug set at 200' - cemented with 20 sax bulk cement - set wood plug at base of cellar, cemented with 5 sax bulk cement.

(If additional description is necessary, use BACK of this sheet)

Correspondence regarding this well should be addressed to. William Herbert Hunt Trust Estate
Address. 1107 City Bank Bldg., Shreveport, La.

STATE OF Kansas, COUNTY OF Barton, ss.


(employee of owner) or (owner or operator) of the above-described well,
being first duly sworn on oath, says: That I have knowledge of the facts, statements, and matters herein contained and the log of the above-described well as filed and that the same are true and correct. So help me God.

(Signature) C.M. Roberts
Drilling Superintendent

(Address) _____

SUBSCRIBED AND SWORN to before me this 6 day of July, 1948

My commission expires with life

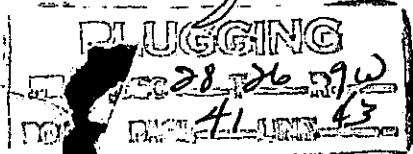

7-8-48

Notary Public

WELL LOG

15-155-65439-0000

William Herbert Hunt Trust Estate
Maude Dutton #1

Sec. 28-1-26S-R. 9W
NE/4 SE/4
County: Reno, Kansas.

Total Depth - 4400'
Comm: 6-12-48 Comp.: 6-30-48
Contractor: J. D. Ferrell Drilling Co., Inc.
Issued: 6-30-48

Elevation: 1693'
Production: Dry

Casing:
130' 8 5/8" Cemented with 125 sax cement
Cement circulated

Figures indicate bottom of formations.

cellar 5
clay 40
sand & shells 95
shale & shells 130
Red Bed 160
Red Bed & shells 675
shale 760
shale, salt & shells 1195
shale & salt 1250
bro. lime 1385
lime 1500
Broken lime 1580
lime 1650
shale & shells 1710
lime (broken) 1825
shale & shells 1935
shale & lime 2175
shale & shells 2507
lime & shale 2545
shale & shells 2590
sandy shale & Broken lime 2680
shale & lime 2810
lime 3025
lime (soft) 3170
lime 3285
lime & shale 3377
lime 3473
lime & chert 3520
lime 3745
lime & shale 3880
lime 3900
lime & shale 3933
Chert & lime 3950
Mississippi Lime 4000
chat, chert & shale 4043
shale 4175
lime 4192
cherty lime & shale 4217
lime (hard) 4240
lime 4258
shale & lime 4272
sand & lime 4360
Dolomitic lime 4400

Tops:
Topeka 2810
Hubner 3191
Brown Lime 3366
Kansas City 3377
Mississippi 3932
Viola 4170
Simpson Shale 4258
Arbuckle 4347
Total Depth 4400

We hereby certify this to be a correct and accurate log of the above described well as shown by the daily drilling reports.

PLUGGING
WELL NO. 28-1-26S-R. 9W
DATE 6/30/48
BY J. D. FERRELL DRILLING COMPANY, INC.

Subscribed and sworn to before me this 30 day of June 1948

My commission expires: 10-15-51

Merle V. Solidy
Notary Public.