


Give All Information Completely  
Make Required Affidavit  
Mail or Deliver Report to:  
Conservation Division  
State Corporation Commission  
211 No. Broadway  
Wichita, Kansas

WELL PLUGGING RECORD 15-455-19083-0000

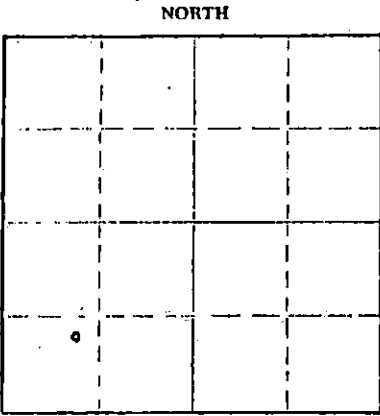

Locate well correctly on above Section Flat

Reno County, Sec. 28 Twp. 26 Rge. (E) 9 (W)  
Location as "NE/CNWSW" or footage from lines NE SW SW  
Lease Owner Edwin G. Bradley  
Lease Name Bell Unit Well No. 1  
Office Address 826 Union Center, Wichita, Kansas  
Character of Well (completed as Oil, Gas or Dry Hole) oil  
Date well completed \_\_\_\_\_ 19\_\_\_\_  
Application for plugging filed January 12 1965  
Application for plugging approved January 13 1965  
Plugging commenced January 11 1965  
Plugging completed January 18 1965  
Reason for abandonment of well or producing formation depleted

If a producing well is abandoned, date of last production \_\_\_\_\_ 19\_\_\_\_  
Was permission obtained from the Conservation Division or its agents before plugging was commenced? yes

Name of Conservation Agent who supervised plugging of this well Gilbert Toman  
Producing formation \_\_\_\_\_ Depth to top \_\_\_\_\_ Bottom \_\_\_\_\_ Total Depth of Well 3980 Feet  
Show depth and thickness of all water, oil and gas formations.

OIL, GAS OR WATER RECORDS

CASING RECORD

FORMATION	CONTENT	FROM	TO	SIZE	PUT IN	PULLED OUT
		0	310	8 5/8"	310'	none
		0	3978	5 1/2"	3978	2740.23

Describe in detail the manner in which the well was plugged, indicating where the mud fluid was placed and the method or methods used in introducing it into the hole. If cement or other plugs were used, state the character of same and depth placed, from \_\_\_\_\_ feet to \_\_\_\_\_ feet for each plug set.

Pushed plug to 3930', set 10' rock bridge and dumped 5 sacks of cement.  
Bail hole down to 300', set 10' rock bridge and dump 20 sacks of cement. Fill hole with mud to 40', set 10' rock bridge and cap with 10 sacks of cement.

RECEIVED  
STATE CORPORATION COMMISSION

FEB 15 1965 2-15-65

CONSERVATION DIVISION  
Wichita, Kansas

(If additional description is necessary, use BACK of this sheet)

Name of Plugging Contractor Pipe Pullers, Inc.  
Address Box 186, Ellinwood, Kansas

STATE OF Kansas COUNTY OF Barton, ss.  
Dean Wells (employee of owner) or (owner or operator) of the above-described well, being first duly sworn on oath, says: That I have knowledge of the facts, statements, and matters herein contained and the log of the above-described well as filed and that the same are true and correct. So help me God.

(Signature) Dean Wells  
Ellinwood, Kansas  
(Address)

SUBSCRIBED AND SWORN to before me this 25th day of January, 1965

J. Rader  
Notary Public.

My commission expires July 7, 1968

15-155-19083-0000

28-26-9

WELL LOG

Well: Bell #1 Contractor: Twin Drilling, Inc.  
 Location: C NE/4 SW/4 SW/4 1005 Central Building  
 Sec. 28-26-9 Wichita, Kansas  
 Reno County, Kansas  
 Operator: Edwin G. Bradley Commenced: 8-21-58  
 Union Center Completed: 8-30-58  
 Wichita, Kansas  
 Casing: 310' 8 5/8" Surface Elevation: 1714 R.B.  
 W/175 Saz, 2% Gel  
 & 2% Cal. Chloride

Surface 180  
 Shale & Shells 312  
 Shale-Redbed 700  
 Shale & Shells 980  
 Shale & Lime Streaks 1471  
 Lime-Shale 2547  
 Shale-Lime Streaks 2840  
 Lime & Shale 2870  
 Lime 3189  
 Shale & Lime 3397  
 Lime 3754  
 Shale & Lime 3816  
 Lime 3941  
 Chat 3980  
 R.T.D. 3980

Tops  
 Heebner 3225'  
 Brown Lime 3391'  
 Lansing 3416'  
 Base K.C. 3726'  
 Conglomerate 3915'  
 Mississippi 3934'

RECEIVED  
 STATE CORPORATION COMMISSION  
 FEB 17 1965  
 CONSERVATION DIVISION  
 Wichita, Kansas

STATE OF KANSAS )  
 ) ss.  
 COUNTY OF SEDGWICK )

The undersigned, TWIN DRILLING, INC., hereby certifies that the above log is a true and correct log of the formations encountered in drilling the above well as reflected by the Daily Drilling Report.

TWIN DRILLING, INC.

By: *Edwin G. Bradley*

Subscribed and sworn to before me this 12th day of September, 1958.

*Notary Public*  
 Notary Public

My commission expires September 29, 1960.