

15455-19130-0000


STATE OF KANSAS  
STATE CORPORATION COMMISSION

Form CP-4

WELL PLUGGING RECORD

Give All Information Completely  
Make Required Affidavit  
Mail or Deliver Report to:  
Conservation Division  
State Corporation Commission  
212 No. Market  
Wichita, Kansas 67202

Reno County, Sec. 32 Twp. 26 Rge. 9 (E) W (W)  
Location as "NE/CNW/SW" or footage from lines NW 1/4 SE 1/4  
Lease Owner Messman - Rinehart Oil Co.  
Lease Name Huffman Well No. # 1  
Office Address 1432 Wichita Plaza ; Wichita, Ks. 67202  
Character of Well (completed as Oil, Gas or Dry Hole)  
Date well completed 19  
Application for plugging filed April 1971  
Application for plugging approved April 1971  
Plugging commenced April 22 1971  
Plugging completed April 26 1971  
Reason for abandonment of well or producing formation

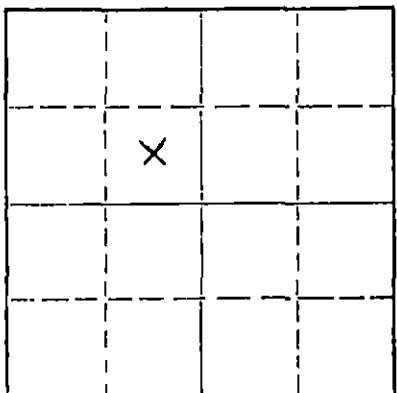

Locate well correctly on above Section Plat

If a producing well is abandoned, date of last production 19  
Was permission obtained from the Conservation Division or its agents before plugging was commenced? Yes

Name of Conservation Agent who supervised plugging of this well Gib Toman  
Producing formation Depth to top Bottom Total Depth of Well Feet  
Show depth and thickness of all water, oil and gas formations.

OIL, GAS OR WATER RECORDS

CASING RECORD

FORMATION	CONTENT	FROM	TO	SIZE	PUT IN	PULLED OUT
				8 5/8	276	None
				4 1/2	4000	2834

Describe in detail the manner in which the well was plugged, indicating where the mud fluid was placed and the method or methods used in introducing it into the hole. If cement or other plugs were used, state the character of same and depth placed, from feet to feet for each plug set.

April 22, 1971 Plugged off bottom. Dumped sand to 3900'. Mixed and dumped 4 sx of cement to 3850'.  
April 26, 1971 Plugged off top. Set 15' rock bridge from 265' to 250'. Mixed and dumped 25 sx of cement. Mudded casing to 40'. Set 10' rock bridge from 40' to 30'. Mixed and dumped 10 sx of cement from 30' to base of cellar.

RECEIVED  
STATE CORPORATION COMMISSION  
MAY 17 1971  
CONSERVATION DIVISION  
Wichita, Kansas

(If additional description is necessary, use BACK of this sheet)  
Name of Plugging Contractor Russ Casing Pulling, Inc.  
Address P. O. Box 1082 Great Bend, Kansas 67530

STATE OF Kansas, COUNTY OF Sedgwick, ss.  
J. A. Gilliland (employee of owner) or (owner) of the above-described well, being first duly sworn on oath, says: That I have knowledge of the facts, statements, and matters herein contained and the log of the above-described well as filed and that the same are true and correct. So help me God.

(Signature) [Signature]  
1432 Wichita Plaza, Wichita, Kansas 67202 (Address)

SWORN to before me this 6th day of May, 1971  
Arlene L. Sloop Notary Public.

