


Give All Information Completely
Make Required Affidavit
Mail or Deliver Report to:
Conservation Division
State Corporation Commission
800 Bitting Building
Wichita, Kansas

WELL PLUGGING RECORD

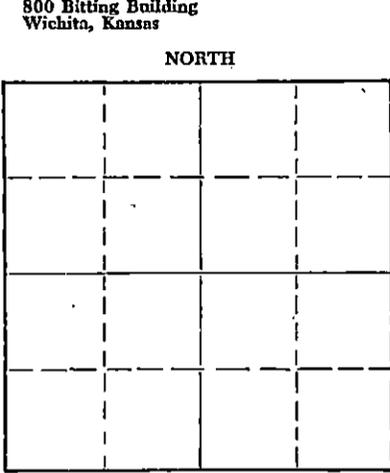

Locate well correctly on above Section Plat

Reno County, Sec. 5 Twp. 26 Rge. (E) 10 (W)
Location as "NE/CNW%SW%" or footage from lines SW SW SW
Lease Owner Rupp-Ferguson Oil Co.
Lease Name Hickman Well No. 1
Office Address 523 Petroleum Bldg., Wichita, Kansas
Character of Well (completed as Oil, Gas or Dry Hole) Dry Hole
Date well completed 9-26-54 19
Application for plugging filed 9-26-54 19
Application for plugging approved 9-26-54 19
Plugging commenced 9-26-54 19
Plugging completed 9-26-54 19
Reason for abandonment of well or producing formation _____

If a producing well is abandoned, date of last production _____ 19
Was permission obtained from the Conservation Division or its agents before plugging was commenced? Yes

Name of Conservation Agent who supervised plugging of this well Ruel E. Durkee
Producing formation _____ Depth to top _____ Bottom _____ Total Depth of Well 4379 Feet
Show depth and thickness of all water, oil and gas formations.

OIL, GAS OR WATER RECORDS

CASING RECORD

FORMATION	CONTENT	FROM	TO	SIZE	PUT IN	PULLED OUT
				8 5/8	264	0

Describe in detail the manner in which the well was plugged, indicating where the mud fluid was placed and the method or methods used in introducing it into the hole. If cement or other plugs were used, state the character of same and depth placed, from _____ feet to _____ feet for each plug set.

Filled hole to 250', bridged hole - 15 sacks cement on lower plug.
Filled to 35', bridged and cemented to base of cellar.

STATE CORPORATION COMMISSION

9-30-54

CONSERVATION DIVISION
Wichita, Kansas

(If additional description is necessary, use BACK of this sheet)

Name of Plugging Contractor Rupp-Ferguson Oil Co.
Address 523 Petroleum Bldg., Wichita, Kansas

STATE OF Kansas, COUNTY OF Sedgwick, ss.
L. W. Knox (employee of owner) of the above-described well, being first duly sworn on oath, says: That I have knowledge of the facts, statements, and matters herein contained and the log of the above-described well as filed and that the same are true and correct. So help me God.


(Signature) L. W. Knox
523 Petroleum Bldg., Wichita, Kansas
(Address)

SUBSCRIBED AND SWORN TO before me this 29th day of September, 1954

Helen Horine

Notary Public.

My commission expires 6-4-55

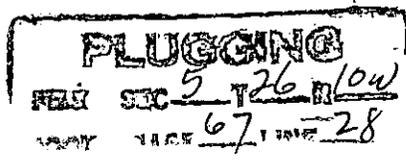

15-155-10337-0000

CONTRACTOR'S WELL LOG

Hickman No. 1
SW SW SW, Sec. 5-26-10W, Reno County, Kansas
Contractor: Rupp-Ferguson Oil Co.
Commenced: 9-11-54
Completed: 9-26-54

D & A
Elevation 1764 KB

160 red drlg. sandstone	Tops:	
265 red rock, red bed		
450 red bed	Heebner shale	3322 (-1558)
465 Anhydrite	Brown Lime	3498 (-1734)
900 red bed, salt, shale	Lansing-Kansas City	3510 (-1746)
1260 shale & shells	Mississippi	3973 (-2209)
3025 lime & shale	Kinderhook	4042 (-2278)
3167 lime	Viola	4202 (-2438)
3386 lime & shale	Simpson	4301 (-2537)
3422 sandy lime & shale	Arbuckle (est.)	4388 (-2624)
3595 lime & shale	T.D.	4379 (-2615)
3870 lime		
3927 lime & shale		
3973 lime		
4010 lime & chert		
4030 lime & shale		
4039 shale		
4200 lime & shale		
4213 chert		
4283 lime & chert		
4324 lime & shale		
4340 lime, shale & sand		
4379 lime & shale		

STATE OF KANSAS)
) SS:
COUNTY OF SEDGWICK)

I, L. W. Knox, Landman for Rupp-Ferguson Oil Co., do hereby certify that the above and foregoing is a true and correct copy of the log of the No. 1 Hickman well.

L. W. Knox

L. W. Knox

Subscribed and sworn to before me this 29th day of September, 1954.

Helen Horine

Notary Public
RECEIVED
STATE CORPORATION COMMISSION

My Commission Expires: 6-4-55

PLUGGING
FILE SEC 5-26-10W
BOOK PAGE 67 LINE 28

SEP 30 1954
CONSERVATION DIVISION
Wichita, Kansas