


WELL PLUGGING RECORD

Give All Information Completely
Make Required Affidavit
Mail or Deliver Report to:
Conservation Division
State Corporation Commission
808 Biting Building
Wichita, Kansas

NORTH

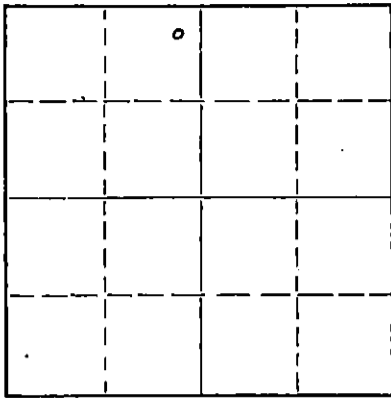

Locate well correctly on above Section Plat

Reno County. Sec. 15 Twp. 26S Rge. 10(W)
Location as "NE/CNW/SW" or footage from lines NE/4 NW/4 NW/4
Lease Owner T. O. Lilystrand, Jr. No. 2, A Ltd. Pt.shp.
Lease Name Merle Fluke Well No. 1
Office Address 1018 First Nt. Bldg., Tulsa, Oklahoma
Character of Well (completed as Oil, Gas or Dry Hole) Dry hole
Date well completed February 9, 1957
Application for plugging filed February 18, 1957
Application for plugging approved February 18, 1957
Plugging commenced February 9, 1957
Plugging completed February 10, 1957
Reason for abandonment of well or producing formation Dry hole

If a producing well is abandoned, date of last production _____ 19____
Was permission obtained from the Conservation Division or its agents before plugging was commenced? Yes

Name of Conservation Agent who supervised plugging of this well Ruel Durkee, Box 597, McPherson, Kansas
Producing formation _____ Depth to top _____ Bottom _____ Total Depth of Well 4400 Feet
Show depth and thickness of all water, oil and gas formations.

OIL, GAS OR WATER RECORDS

CASING RECORD

FORMATION	CONTENT	FROM	TO	SIZE	PUT IN	PULLED OUT
<u>Lansing-Kansas City</u>	<u>Water</u>	<u>3471</u>	<u>3832</u>	<u>8 5/8"</u>	<u>306</u>	<u>None</u>
<u>Mississippi Lime</u>	<u>SSO</u>	<u>3043</u>	<u>4815</u>			
<u>Arbuckle Lime</u>	<u>Water</u>	<u>4369</u>				

RECEIVED
STATE CORPORATION COMMISSION
FEB 21 1957
CONSERVATION DIVISION
Wichita, Kansas

Describe in detail the manner in which the well was plugged, indicating where the mud fluid was placed and the method or methods used in introducing it into the hole. If cement or other plugs were used, state the character of same and depth placed, from _____ feet to _____ feet for each plug set.

Bridged at 280'. Cemented w/20 sax on top.
Plugged to 30' w/10 sax.cement.

(If additional description is necessary, use BACK of this sheet)

Name of Plugging Contractor Stickle Drilling Company
Address Great Bend, Kansas

STATE OF OKLAHOMA, COUNTY OF TULSA, ss.
T. O. Lilystrand, Jr. (employee of owner) or (owner or operator) of the above-described well, being first duly sworn on oath, says: That I have knowledge of the facts, statements, and matters herein contained and the log of the above-described well as filed and that the same are true and correct. So help me God.

(Signature) T. O. Lilystrand, Jr.
General Partner

(Address)

SUBSCRIBED AND SWORN TO before me this 20th day of February, 19 57

Edith A. Lawver
Edith A. Lawver Notary Public.

My commission expires March 24, 1960

PLUGGING
FILE SEC 15 T 26 R 10 W
BOOK PAGE 141 LINE 23

15-155-00487-0000

T. O. Lilystrand, Jr. - A Limited Partnership
Tulsa, Oklahoma

Tulsa, Oklahoma
February 12, 1957

CONTRACTOR: Stickle Drilling Company
Drilling Commenced: January 24, 1957
Drilling Completed: February 10, 1957

Merle Fluke #1 - NE NW NW
Section 15-26S-10W, Reno
County, Kansas.

Dry Hole

DRILLERS LOG

Depth Figures Indicate Base of Formation

Sand	60
Red Bed & Shells	306
Red Bed & Shale	425
Shale & Shells	1000
Anhydrite	1040
Shale & Shells	1560
Shells, Shale & Sand	1700
Lime	1835
Lime & Shale	2170
Shale & Lime Shells	2345
Shale & Shells	2585
Shale & Lime	2725
Lime & Shale Breaks	2950
Shale & Shells	3115
Shale & Lime	3235
Lime & Shale	3405
Shale & Shells	3455
Lime	3550
Kansas City Lime	3610
Lime	3845
Lime & Shale	3903
Lime	3955
Conglomerate Chert	3966
Lime Chert	4002
Lime	4022
Shale	4088
Shale & Lime	4140
Shale	4205
Dolomite	4230
Lime	4279
Viola Lime	4300
Sand	4310
Lime	4400 TD

RECEIVED
STATE CORPORATION COMMISSION
FEB 21 1957
CONSERVATION DIVISION
Wichita, Kansas

I, Frank E. Stickle, hereby certify the above to be a true and complete Driller's Log of T. O. Lilystrand, Jr. - A Limited Partnership, Merle Fluke #1, NE NW NW - Section 15-26S-10W, Reno County, Kansas.

Frank E. Stickle
Frank E. Stickle

Lillian T. Bonham
Notary Public

February 13, 1960
My Commission Expires

PLUGGING
FILE SEC. 15 T. 26 R. 10W
BOOK PAGE 141 LINE 23