


15-155-00346-0000

STATE OF KANSAS
STATE CORPORATION COMMISSION
Give All Information Completely
Make Required Affidavit
Mail or Deliver Report to:
Conservation Division
State Corporation Commission
211 No. Broadway
Wichita, Kansas

WELL PLUGGING RECORD

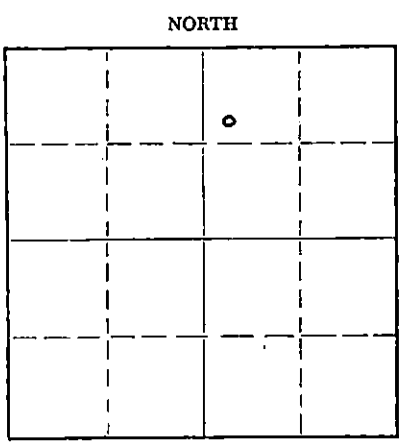

Reno County, Sec. 34 Twp. 26 Rge. (E) 10 (W)
Location as "NE/CNW/SW" or footage from lines SW NW NE
Lease Owner Aylward Drilling Company
Lease Name Tredway Well No. 1
Office Address 813 First National Bank Bldg. - Wichita 2, Kansas
Character of Well (completed as Oil, Gas or Dry Hole) Dry hole
Date well completed April 19 1959
Application for plugging filed April 19 1959
Application for plugging approved April 19 1959
Plugging commenced April 20 1959
Plugging completed April 20 1959
Reason for abandonment of well or producing formation

If a producing well is abandoned, date of last production 19
Was permission obtained from the Conservation Division or its agents before plugging was commenced? Yes

Name of Conservation Agent who supervised plugging of this well W. L. Lecamp - Stafford, Kansas
Producing formation Depth to top Bottom Total Depth of Well 4450 Feet
Show depth and thickness of all water, oil and gas formations.

OIL, GAS OR WATER RECORDS				CASING RECORD		
FORMATION	CONTENT	FROM	TO	SIZE	PUT IN	PULLED OUT
				8 5/8"	282'	None

Describe in detail the manner in which the well was plugged, indicating where the mud fluid was placed and the method or methods used in introducing it into the hole. If cement or other plugs were used, state the character of same and depth placed, from feet to feet for each plug set.

Well filled with heavy mud from 4450 to 275. A Halliburton plug set at 275' with 20 sacks cement and 1/3 sack of hulls. Cement from 275 to 225'. Heavy mud from 225 to 35'. A Halliburton plug set at 35' with 10 sacks of cement and 1/3 sack hulls. Cement to top of surface. Plugging was completed at 12:00 noon 4/20/59.

RECEIVED
4-23-59
STATE CORPORATION COMMISSION
APR 23 1959
CONSERVATION DIVISION
Wichita, Kansas

(If additional description is necessary, use BACK of this sheet)
Name of Plugging Contractor Aylward Drilling Company
Address 813 1st Nat'l Bank Bldg., Wichita 2, Kansas

STATE OF Kansas, COUNTY OF Sedgwick, ss.
Charles D. Williams (employee of owner) of the above-described well, being first duly sworn on oath, says: That I have knowledge of the facts, statements, and matters herein contained and the log of the above-described well as filed and that the same are true and correct. So help me God.

(Signature) Charles D. Williams
813 1st Nat'l Bank Bldg., Wichita 2, Kansas
(Address)

SUBSCRIBED AND SWORN TO before me this 22nd day of April, 1959
Duane Jessup
DUANE JESSUP Notary Public.
My commission expires December 11, 1961

PLUGGING
FILE SEC. 34 T. 26 R. 10
BOOK PAGE 32 LINE 41

TREDWAY NO. 1

15-155-00346-0000

Casing Records:

Company: Aylward-Drilling Company
Contractor: Aylward Drilling CompanyLocation: SW NW NE 36-26-10W
Reno County, Kansas

8 5/8" - 282'

Commenced: April 7, 1959
Completed: April 20, 1959

Elevation: 1709 R.B.

	From	To	Remarks
Sand	0	85	Set 8 5/8" surface pipe @ 282' w/250 sacks cement.
Red Rock	85	282	
Red Bed	282	850	
Salt & blue shale	850	1150	Geological Tops:
Shells & shale	1150	1310	
Shale w/shells	1310	1440	Heebner 3322
Lime & shale	1440	1465	Toronto 3335
Lime w/vry little shale	1465	1565	Douglas 3342
Lime & shale	1565	2315	Brown Lime 3499
Shale	2315	2575	Lansing 3509
Shale & lime	2575	2860	B/Kansas City 3880
Shale w/lime	2860	2868	Mississippian 4009
Sand & shale	2868	3200	Kinderhook 4043
Sandy lime & shale	3200	3340	Maquoketa 4193
Sandy lime w/shale	3340	3500	Viola 4260
Lime & shale	3500	3525	Simpson 4341
Lime	3525	3951	Arbuckle 4429
Cherty lime & shale	3951	4023	R.T.D. 4450
Lime	4023	4049	
Lime & shale	4049	4115	
Shale	4115	4184	DST 4005-23 Open 1 hr. Wk. bl. 5".
Shale & lime	4184	4206	Rec. 20" mud. 1BHP 1595/20",
Lime	4206	4260	FBHP 875#/30".... FP 22"-35".
Cherty Lime	4260	4329	
Cherty lime & shale	4329	4341	Logged. D & A
Shale & sandy shale	4341	4429	
Lime & chert	4429	4450 T.D.	

RECEIVED
STATE CORPORATION COMMISSION

MAY 21 1959

CONSERVATION DIVISION
Wichita, Kansas.

I hereby certify that this is a true and correct copy of the above log to the best of my knowledge.

Paul W. Hesse

Subscribed and sworn to before me this 22nd day of April, 1959.

Duane Jessup
DUANE JESSUP Notary Public

My commission expires December 11, 1961

