


STATE OF KANSAS
STATE CORPORATION COMMISSION

WELL PLUGGING RECORD

Give All Information Completely
Make Required Affidavit
Mail or Deliver Report to:
Conservation Division
State Corporation Commission
212 No. Market
Wichita, Kansas

NORTH

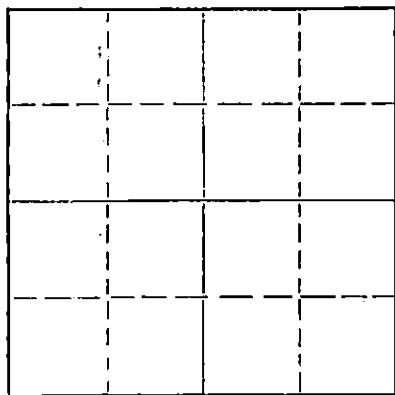

Locate well correctly on above
Section Plat

Kiowa County, Sec. 21 Twp. 27S Rgd. 9W ~~XDE~~ (W)
Location as "NE/CNW/SW" or footage from lines C NW NW
Lease Owner William H. Pine
Lease Name Barnes Well No. 1
Office Address McCulloch Bldg., Okmulgee, Okla.
Character of Well (completed as Oil, Gas or Dry Hole) Dry Hole
Date well completed 5-5-68 19
Application for plugging filed 5-5-68 19
Application for plugging approved 5-5-68 19
Plugging commenced 5-5-68 19
Plugging completed 5-5-68 19
Reason for abandonment of well or producing formation Dry Hole

If a producing well is abandoned, date of last production 19
Was permission obtained from the Conservation Division or its agents before plugging was commenced? yes

Name of Conservation Agent who supervised plugging of this well Leo Massey
Producing formation _____ Depth to top _____ Bottom _____ Total Depth of Well 4895 Feet
Show depth and thickness of all water, oil and gas formations.

OIL, GAS OR WATER RECORDS

CASING RECORD

FORMATION	CONTENT	FROM	TO	SIZE	PUT IN	PULLED OUT
				8 5/8"	328'	none

Describe in detail the manner in which the well was plugged, indicating where the mud fluid was placed and the method or methods used in introducing it into the hole. If cement or other plugs were used, state the character of same and depth placed, from _____ feet to _____ feet for each plug set.

Filled hole with mud to 300', plug, 25 sks. cement
Mud to 40', plug, 1/2 sk. hulls, 10 sks. cement

RECEIVED
STATE CORPORATION COMMISSION
MAY 9 1968
CONSERVATION DIVISION
Wichita, Kansas

(If additional description is necessary, use BACK of this sheet)

Name of Plugging Contractor Leben Drilling, Inc.
Address Box 486, Great Bend, Kansas 67530

STATE OF KANSAS, COUNTY OF BARTON, ss.
Leslie Kite (employee of owner) or (owner or operator) of the above-described well, being first duly sworn on oath, says: That I have knowledge of the facts, statements, and matters herein contained and the log of the above-described well as filed and that the same are true and correct. So help me God.

(Signature) Leslie Kite
Box 486, Great Bend, Kansas 67530
(Address)

SUBSCRIBED AND SWORN TO before me this 8th day of May, 1968

My commission expires April 1, 1971
Ulanda Nichols Notary Public.

DRILLER'S LOG

COMPANY: William H. Pine
 CONTRACTOR: LEBEN DRILLING, INC.
 FARM: BARNES #1
 LOCATION: C NW NW SECTION 21-27S-19W
 KIOWA COUNTY, KANSAS
 COMMENCED: 4-26-68
 COMPLETED: 5-5-68

0	205	Sand
205	330	Shale
330	663	Shale, redbed
663	679	Anhydrite
679	1060	Shale, redbed
1060	1240	Redbed
1240	1256	Anhydrite
1256	2100	Shale
2100	2370	Lime, shale
2370	2485	Lime
2485	3214	Lime, shale
3214	3600	Shale, lime
3600	4230	Lime, shale
4230	4715	Lime
4715	4895	Lime, chert
	<u>4895</u>	<u>RTD - D. & A.</u>

RECEIVED
 STATE CORPORATION COMMISSION
 MAY 9 1968
 CONSERVATION DIVISION
 Wichita, Kansas

8 5/8" new 20# surface casing set @ 328' cemented with 350 sacks
 Common, 2% cc

I, Leslie Kite, do hereby certify that the above and foregoing is a true and correct copy of the log of the Barnes #1 Well, located C NW NW of Section 21, Township 27 South, Range 19 West, Kiowa County, Kansas, as reflected by the records of Leben Drilling, Inc.

Leslie Kite
 Leslie Kite

STATE OF KANSAS)
) SS
 COUNTY OF BARTON)

Subscribed and sworn to and before me, a Notary Public, in and for Barton County, Kansas, this 8th day of May, 1968.

Ulanda Nichols
 Ulanda Nichols

My Commission Expires:
 April 1, 1971