


STATE OF KANSAS
STATE CORPORATION COMMISSION

WELL PLUGGING RECORD

Give All Information Completely
Make Required Affidavit
Mail or Deliver Report to:
Conservation Division
State Corporation Commission
212 No. Market
Wichita, Kansas

NORTH

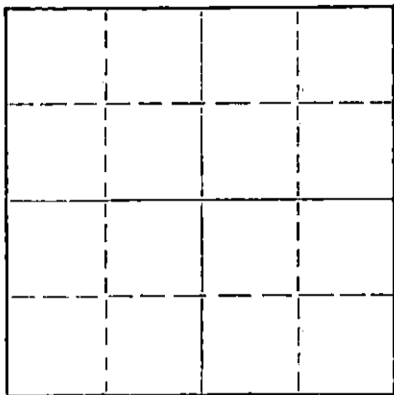

Locate well correctly on above
Section Plat

Kiowa County, Sec. 21 Twp. 27S Rge. 19W (E) (W)
Location as "NE/CNW/SW" or footage from line SW NENE
Lease Owner Pickrell Drilling Company
Lease Name Barnes "C" Well No. 1
Office Address 705 4th National Bank Bldg., Wichita, Kansas
Character of Well (completed as Oil, Gas or Dry Hole) Dry Hole
Date well completed October 27, 1968 19
Application for plugging filed October 27, 1968 19
Application for plugging approved October 27, 1968 19
Plugging commenced October 27, 1968 19
Plugging completed October 27, 1968 19
Reason for abandonment of well or producing formation Dry Hole

If a producing well is abandoned, date of last production 19
Was permission obtained from the Conservation Division or its agents before plugging was commenced? Yes

Name of Conservation Agent who supervised plugging of this well Archie Elving, Pratt, Kansas
Producing formation _____ Depth to top _____ Bottom _____ Total Depth of Well 4835 Feet
Show depth and thickness of all water, oil and gas formations.

OIL, GAS OR WATER RECORDS

CASING RECORD

FORMATION	CONTENT	FROM	TO	SIZE	PUT IN	PULLED OUT
				8 5/8	320	

Describe in detail the manner in which the well was plugged, indicating where the mud fluid was placed and the method or methods used in introducing it into the hole. If cement or other plugs were used, state the character of same and depth placed, from _____ feet to _____ feet for each plug set.

Heavy mud to 600'. Set plug. Cemented with
50 sacks cement. Heavy mud to 300'. Set plug.
Cemented with 25 sacks cement. Heavy mud to
40'. Set plug. Cemented with 10 sacks cement.
Plugged rat hole with 2 sacks cement.

RECEIVED
STATE CORPORATION COMMISSION
NOV 8 1968
CONSERVATION DIVISION
Wichita, Kansas

(If additional description is necessary, use BACK of this sheet)

Name of Plugging Contractor Pickrell Drilling Company
Address 705 4th National Bank Building, Wichita, Kansas

STATE OF Kansas, COUNTY OF Sedgwick, ss.
C. W. Sebitts (employee of owner) or (owner or operator) of the above-described well, being first duly sworn on oath, says: That I have knowledge of the facts, statements, and matters herein contained and the log of the above-described well as filed and that the same are true and correct. So help me God.

(Signature) C. W. Sebitts
705 4th National Bank Building, Wichita, Kansas
(Address)

SUBSCRIBED AND SWORN TO before me this 4th day of November, 19 68

My commission expires May 10, 1970

L. M. Whiting
Notary Public.

ROTARY DRILLING LOG

COMPANY: PICKRELL DRILLING COMPANY
 705 4th National Bank Building
 Wichita, Kansas
 LOCATION: Barnes "C", SW NE NE Sec. 21-27S-19W, Kiowa

Rotary Drilling Commenced 10-14-68
 Rotary Drilling Completed 10-27-68

CONTRACTOR: **PICKRELL DRILLING COMPANY**
Wichita, Kansas

CASING RECORD: Ran 8 Jts. 20# 8 5/8 " casing set @ 320' KB. Cemented with 225 sacks cement. Circulated. Completed 6:00 PM, 10-14-68. Dry hole.

LOG

(Figures indicate bottom of formation — measurements from top of rotary bushing.)

165	Sand	C. F. S.
215	Clay & Shale	<u>4370</u>
322	Shale & Shells	4790
510	Shale w/sand streaks	4812
765	Red Bed	4822
1214	Red Beds, Shale & Shells	4835
1255	Anhydrite	
1890	Shale & Shells	
2470	Lime & Shale	
2450	Lime	<u>Slope tests</u>
4181	Shale & Lime	2000
4776	Lime	2500
4790	Mississippian	3000
4802	Lime	3500
4812	Mississippian	4000
4822	Lime	4500
4835	RTD	

S. L. M.

RECEIVED
 STATE CORPORATION COMMISSION
 NOV 8 1968
 CONSERVATION DIVISION
 Wichita, Kansas

The undersigned, C. W. Sebitts, Attorney-in-Fact for PICKRELL DRILLING COMPANY, hereby certifies in behalf of said Company, that the above is a true and correct log of the formation encountered in drilling the above well as reflected by the Daily Drilling Reports.

PICKRELL DRILLING COMPANY
 By [Signature]
 C. W. Sebitts Attorney-in-Fact

STATE OF KANSAS }
 COUNTY OF SEDGWICK } ss.:

On this 4th day of November, 1968, before me the undersigned, a Notary Public, in and for the County and State aforesaid, personally appeared C. W. Sebitts, to me known to be the identical person who subscribed the name of PICKRELL DRILLING COMPANY to the foregoing instrument as its Attorney-in-Fact and acknowledged to me that he executed the same as his free and voluntary act and deed, and as the free and voluntary act and deed of such company, for the uses and purposes therein set forth.

Given under my hand and seal of office the day and year last above written.

My commission expires: May 10, 1970

[Signature]
 L. M. Whiting Notary Public

