

WELL PLUGGING RECORD

Give All Information Completely
Make Required Affidavit
Mail or Deliver Report to:
Conservation Division
State Corporation Commission
212 No. Market
Wichita, Kansas

Kiowa County, Sec. 18 Twp. 27 Rge. 19 (~~W~~) (W)

Location as "NE/CNWSW" or footage from lines NW NW

Lease Owner Godsey-Earlougher Div., Williams Bros. Engr. Co.

Lease Name Zimmerman Well No. 1

Office Address 6600 S. Yale, Tulsa, OK 74136

Character of Well (completed as Oil, Gas or Dry Hole) Dry Hole

Date well completed September 20 1977

Application for plugging filed December 27 1977

Application for plugging approved September 22 1977


Plugging commenced September 20 1977

Plugging completed September 20 1977

Reason for abandonment of well or producing formation Dry Hole

If a producing well is abandoned, date of last production _____ 19____

Was permission obtained from the Conservation Division or its agents before plugging was commenced? Yes

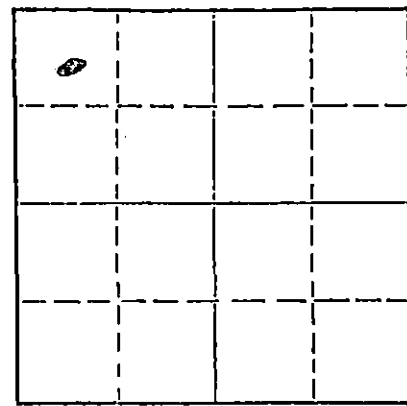

NORTH

Locate well correctly on above Section Plat

Name of Conservation Agent who supervised plugging of this well William T. Owen

Producing formation Mississippi Depth to top 4828 Bottom 4920 Total Depth of Well 4920 Feet

Show depth and thickness of all water, oil and gas formations.

OIL, GAS OR WATER RECORDS

CASING RECORD

FORMATION	CONTENT	FROM	TO	SIZE	PUT IN	PULLED OUT
				8-5/8"	468	none

Describe in detail the manner in which the well was plugged, indicating where the mud fluid was placed and the method or methods used in introducing it into the hole. If cement or other plugs were used, state the character of same and depth placed, from _____ feet to _____ feet for each plug set.

40 sacks regular cement @ 490 feet
35 sacks regular cement @ 300 feet
12 sacks regular cement @ 40 feet
5 sacks regular cement @ rat hole

RECEIVED
STATE CORPORATION COMMISSION
JAN 26 1978
1-26-78
CONSERVATION DIVISION
Wichita, Kansas

(If additional description is necessary, use BACK of this sheet)

Name of Plugging Contractor Gabbert-Jones Drilling Co.

Address 830 Sutton Place, Wichita, KS 67202

STATE OF Oklahoma, COUNTY OF Tulsa, ss.

_____, (employee of owner) or (owner or operator) of the above-described well, being first duly sworn on oath, says: That I have knowledge of the facts, statements, and matters herein contained and the log of the above-described well as filed and that the same are true and correct. So help me God.

(Signature) R. N. Knoblock

Godsey-Earlougher, 6600 S. Yale, Tulsa, Okla
(Address) 74136

SUBSCRIBED AND SWORN to before me this 3 day of January, 1978

My commission expires 7-17-80

Betty Wortley
Notary Public.

GABBERT-JONES, INC.
 WICHITA, KANSAS
 DRILLERS' WELL LOG

Zimmerman #1
 NW NW Sec 18-27S-19W
 Kiowa County Kansas

Commenced: 9-8-77

Completed: 9-20-77

OPERATOR: VOYAGER PETROLEUMS, INC.

From	Depth to	Formation	Remarks
0	196	Sand-Shale	Ran 12 jts of 8 5/8" csg. set @ 467' Cemented w/280 sks Common 2X G&I PD @ 10:45 p.m. 9-8-77
196	228	Redbed-Shale	
228	477	Shale-Sand	
477	1050	Shale-Sand-Redbed	
1050	1265	Shale-Redbed	
1265	1290	Anhy	
1290	1299	Shale-Redbed	
1299	1675	Shale	
1675	2000	Shale-Shells	
2000	2135	Shale	
2135	2805	Shale-Lime	DRY & ABANDONED
2805	2980	Lime-Shale	
2980	3310	Shale-Lime	
3310	3460	Lime s/shale	
3460	3615	Shale-Lime	
3615	4195	Lime-Shale	
4195	4330	Lime	
4330	4455	Lime-s/shale	
4455	4920	Lime	
	4920 - TD		

STATE OF KANSAS,)
) SS
 COUNTY OF SEDGWICK)

I, the undersigned, being duly sworn on oath, state that the above Drillers' Well Log is true and correct to the best of my knowledge and belief and according to the records of this office.

GABBERT-JONES, INC

James S. Sutton II
 JAMES S. SUTTON II

Subscribed and sworn to before me this 29th day of September, 1977.

Elizabeth J. Edwards
 ELIZABETH J. EDWARDS-NOTARY PUBLIC

My Commission expires February 6, 1979.

