


STATE OF KANSAS
STATE CORPORATION COMMISSION

WELL PLUGGING RECORD

Give All Information Completely
Make Required Affidavit
Mail or Deliver Report to:
Conservation Division
State Corporation Commission
800 Bitting Building
Wichita, Kansas

Kiowa County, Sec. 16 Twp. 27SRge. (E) 19 (W)
Location as "NE/CNW/SW" or footage from lines NE SE SE
Lease Owner Mull Drilling Company, Inc.
Lease Name Barnes Well No. 1
Office Address 6501 East Kellogg, Wichita, Kansas
Character of Well (completed as Oil, Gas or Dry Hole) Dry Hole
Date well completed April 27, 1956 19
Application for plugging filed April 26, 1956 (Verbal) 19
Application for plugging approved April 26, 1956 (Verbal) 19
Plugging commenced April 27, 1956 19
Plugging completed April 27, 1956 19
Reason for abandonment of well or producing formation Dry Hole

NORTH

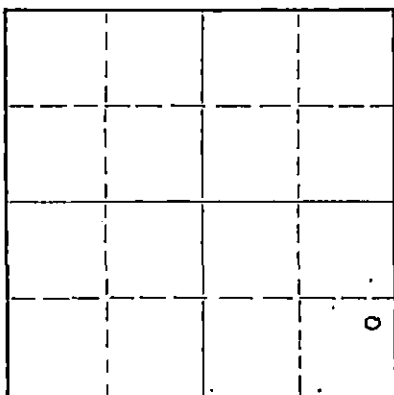

Locate well correctly on above
Section Plat

If a producing well is abandoned, date of last production _____ 19
Was permission obtained from the Conservation Division or its agents before plugging was com-
menced? Yes

Name of Conservation Agent who supervised plugging of this well M. A. Rives, Pratt, Kansas
Producing formation _____ Depth to top _____ Bottom _____ Total Depth of Well 4867 Feet
Show depth and thickness of all water, oil and gas formations.

OIL, GAS OR WATER RECORDS

CASING RECORD

FORMATION	CONTENT	FROM	TO	SIZE	PUT IN	PULLED OUT
				8 5/8"	425'	None

Describe in detail the manner in which the well was plugged, indicating where the mud fluid was placed and the method or methods used in introducing it into the hole. If cement or other plugs were used, state the character of same and depth placed, from _____ feet to _____ feet for each plug set.

Filled hole with heavy
mud to 250 feet. Set plug
and 20 sacks cement through
drill pipe. Filled hole with
mud to 35 feet. Set plug and
1/2 sack hulls and 10 sacks
cement.

(If additional description is necessary, use BACK of this sheet)

Name of Plugging Contractor Graham-Messman-Rinehart Drilling Company (License No. 20)
Address 1005 East Second, Wichita, Kansas

STATE OF Kansas, COUNTY OF Sedgwick ss.
J. A. Gilliland (employee of Contractor) of the above-described
well, being first duly sworn on oath, says: That I have knowledge of the facts, statements, and matters herein contained and the log of the
above-described well as filed and that the same are true and correct. So help me God.

(Signature) J. A. Gilliland
1005 East Second, Wichita, Kansas
(Address)

SUBSCRIBED AND SWORN TO before me this 3rd day of May, 19 56

My commission expires November 5, 1958

Juanita L. Louis
Notary Public.

PLUGGING
FILE SEC 16 T 27 R 19W
BOOK PAGE 58 LINE 2

RECEIVED
STATE CORPORATION COMMISSION
MAY 5-8-56
CONSERVATION DIVISION

NO. 1 BARNES

WELL LOG

Location: NE SE SE, 16-27S-19W.
Kiowa County, Kansas.

Commenced: April 10, 1956

Operator: Hall Drilling Company, Inc.
6405 East Kellogg, Wichita, Kansas

Completed: April 27, 1956

Elevation: 2258 KB (2253 Gr)

Contractor: Graham-Messman-Rinehart Drilling Company
1005 East Second, Wichita, Kansas

Production: D&A

Casing Record: 8 5/8" @ 425' w/300 sacks cement

.....L O G.....

Sand	135
Sand-Clay	190
Sand	220
Shale	540
Shale	590
Sand	618
Shale	656
Red Bed-Shale	1560
Shale-Shells	1860
Salt-Shale	2040
Shale-Lime	2440
Lime-Shale	2670
Lime	2895
Lime-Shale	3020
Lime	3112
Lime-Shale	3645
Shale-Lime	3855
Lime-Shale	4130
Lime	4795
Mississippi	4805
Lime-Chert	4867

R.T.D.

Sample Tops:

- Heebner 4038 (-1780)
- Brn Lime 4184 (-1926)
- Lansing 4190 (-1932)
- Reworked Miss 4784 (-2526)
- Mississippi 4795 (-2537)
- Miss. Lime 4859 (-2601)

The undersigned, GRAHAM-MESSMAN-RINEHART DRILLING COMPANY, hereby certifies that the above log is a true and correct log of the formation encountered in drilling the above well as reflected by the Daily Drilling Report.

GRAHAM-MESSMAN-RINEHART DRILLING COMPANY

By: J. A. Gilliland
J. A. Gilliland

Subscribed and sworn to before me this 3rd day of May, 1956.

Quentin L. Louis
Notary Public

My Commission Expires: November 5, 1958

RECEIVED
STATE OF KANSAS
WICHITA, KANSAS

CONSERVED
WICHITA, KANSAS

PLUGGING
DATE DEC 16 1956
BOOK PAGE 58 LINE 2