

161-1

STATE OF KANSAS
STATE CORPORATION COMMISSION

WELL PLUGGING RECORD
OR
FORMATION PLUGGING RECORD

Strike out upper line when reporting plugging of formations.

Give All Information Completely
Make Required Affidavit
Mail or Deliver Report to:
Conservation Division
State Corporation Commission,
800 Bitting Building,
Wichita, Kansas

Sedgewick County. Sec. 22 Twp. 25 Rge. 1 (B) ES (W)

Location as "NE 1/4, NW 1/4, SW 1/4" or footage from lines.....

Lease Owner Ed Spencer

Lease Name Smith Well No. 1

Office Address 223 So Hillside

Character of Well (Completed as Oil, Gas or Dry Hole) Dry Hole

Date, well completed Aug 1937

Application for plugging filed Aug 2 1937

Application for plugging approved Aug 2 1937


Plugging Commenced Aug 3 1937

Plugging Completed Aug 7 1937

Reason for abandonment of well or producing formation No Oil or Gas

If a producing well is abandoned, date of last production..... 1937

Was permission obtained from the Conservation Division or its agents before plugging was commenced? Yes

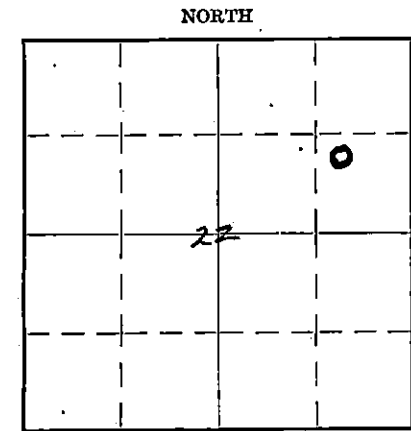

Locate well correctly on above Section Plat

Name of Conservation Agent who supervised plugging of this well Hal C. Smith

Producing formation..... Depth to top..... Bottom..... Total Depth of Well 3242 Feet

Show depth and thickness of all water, oil and gas formations.

OIL, GAS OR WATER RECORDS

CASING RECORD

Formation	Content	From	To	Size	Put In	Pulled Out
	<u>7 in</u>	<u>3242</u>	<u>315 1/2</u>	<u>12 in</u>	<u>110 ft</u>	<u>0</u>
				<u>10 in</u>	<u>825</u>	<u>825</u>
				<u>8 in</u>	<u>1420</u>	<u>1420</u>
					<u>2797</u>	<u>2797</u>

Describe in detail the manner in which the well was plugged, indicating where the mud fluid was placed and the method or methods used in introducing it into the hole. If cement or other plugs were used, state the character of same and depth placed, from.....feet to.....feet for each plug set.

Filled with mud from 3242 to 3100
Set Plug at 200 ft feet in cement
to 150 ft full with mud to top
Put cement cap at bottom of well

No Oil or Gas showing

PLUGGING
FILE SEC 22-25-1E
BOOK PAGE 10 LINE 1

(If additional description is necessary use BACK of this sheet)

Correspondence regarding this well should be addressed to.....

Address:.....

STATE OF....., COUNTY OF....., ss.

.....(employee of owner) or (owner or operator) of the above-described well, being first duly sworn on oath, says: That I have knowledge of the facts, statements, and matters herein contained and the log of the above-described well as filed and that the same are true and correct. So help me God.

(Signature) Ed Spencer

330 So Hillside
(Address)

SUBSCRIBED AND SWORN to before me this 5th day of October, 1937

My commission expires July 17, 1939 16-1484

11-36-5M

Ruth P. Whitman
Notary Public.

WELL LOG
SMITH NO. 1

Completed
Aug. 2, 1937

TED SPENCER

North west cor. SE 1/4 22-25-1E Sedgwick Co. Kans

Cellar	0	10	Shale	2175	2185
Sand	10	108	Lime	2195	2210
Drove 15" to 110			Slate	2210	2375
Slaters' shatters			Lime	2375	2490
Shale	108	220	Sandy Lime	2490	2490 HW 80-90
Slate & Shells	220	265	Lime	2490	2492 Set 8 1/2" @ 2495
Lime	225	325	Slate	2492	2605
Slate & Shells	325	475	Lime	2605	2637 HW 2627-35
Red Rock	475	480	Slate	2637	2661
Slate, blue	480	540	Lime	2661	2685
Red Rock	540	545	Slate	2685	2698
Slate	545	550	Lime	2698	2705 HW 2727-37
Lime	550	535	Slate, black	2705	2771
Slate	535	595	Lime	2771	2835 Ur 8 1/2" to 2797
Lime	595	615	Shale	2835	2905
Lime, broken	615	680	Lime	2905	2915
1 BH 680			Slate & shells	2915	2935
Sandy Lime	680	705	Lime	2935	2985
Slate & Shells	705	760	Slate & shells	2985	2995
Red Rock	760	765	Lime	2995	3020
Lime	765	775	Slate	3020	3030
Lime, sandy	775	805	Lime	3030	3055
1 BH 783-790			Red Rock	3055	3057
Slate	805	820	Shale	3057	3085
Red Rock	820	822	Lime	3085	3085
Broken Lime	822	825	Lime, shells	3085	3107
Set 12 1/2" @ 825			V C Shale	3107	3125
Slate & shells	825	835	Lime & shale	3125	3144
Lime	835	925	Red Rock	3144	3150
Slate & shells	925	1060	Lime	3150	3159
Lime	1060	1090	Chst	3159	3165
Slate & shells	1090	1155	Lime	3165	3242 HW 3230-42
Lime	1155	1180	Total depth		3242
Slate	1180	1190			
Lime	1190	1235			
Broken lime	1235	1245			
Slate, blue	1245	1250			
Lime	1250	1310			
Slate, shale	1310	1360			
Lime	1360	1385			
HW 1368-1390 in sandy lime					
Slate	1385	1400			
Shale	1400	1430			
Set 10" @ 1420					
Lime	1430	1445			
Shale	1445	1460			
Lime	1460	1490			
Shale	1490	1525			
Lime	1525	1540			
Shale	1540	1545			
Red Rock	1545	1547			
Lime	1547	1570			
Shale	1570	1625			
Lime, shells	1625	1630			
Slate	1620	1655			
Lime	1655	1695			
Shale	1695	1720			
Lime	1720	1725			
Shale	1725	1730			
Lime	1730	1845			
Slate	1845	1875			
Lime	1875	1945			
Shale	1945	1955			
Lime	1955	2005			
Slate	2005	2010			
Lime	2010	2105			
Lime, soft	2105	2125			
2 BH 2105-2120					
Shale	2125	2130			
Lime	2130	2175			

State of Kansas
County of Sedgwick

PLUGGING
FILE SEC 22-25-1E
BOOK PAGE 101 LINE 1

Ted Spencer, on his oath, states that the above and foregoing is a true and complete log of the above well and that he was the Drilling Contractor on the same.

Ted Spencer

Subscribed and sworn to before me a Notary Public within said County and State, this 22 day of August, 1937

My commission expires
June 15, 1940

Maxwell Wright
Notary Public

