


STATE OF KANSAS  
STATE CORPORATION COMMISSION  
Give All Information Completely  
Make Required Affidavit  
Mail or Deliver Report to:  
Conservation Division  
State Corporation Commission  
800 Bittling Building  
Wichita, Kansas

WELL PLUGGING RECORD

FORMATION PLUGGING RECORD

Strike out upper line  
when reporting plug-  
ging off formations.

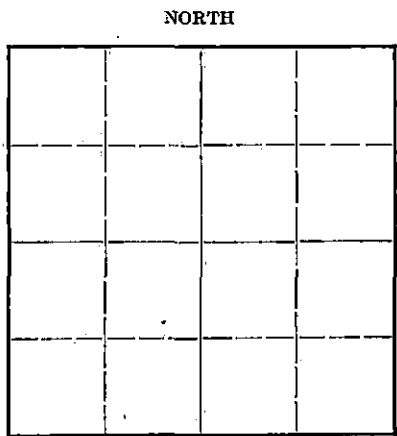

Locate well correctly on above  
Section Plat

Location as "NE $\frac{1}{4}$ NW $\frac{1}{4}$ SW $\frac{1}{4}$ " or footage from lines. sedgwich County. Sec. 12 Twp. 26s Rge. 1w (E) (W)  
Lease Owner. Prunty Production Co,  
Lease Name. A.W.Wright Well No. 3  
Office Address. Ponca, City Okla,  
Character of Well (completed as Oil, Gas or Dry Hole). Oil  
Date well completed. June 27, 1943  
Application for plugging filed. Oct. 1, 1945, 19  
Application for plugging approved. Oct. 11 1945, 19  
Plugging commenced. Oct. 1, 1945 19  
Plugging completed. Oct. 4, 1945 19  
Reason for abandonment of well or producing formation. Salt Water No oil

If a producing well is abandoned, date of last production. April 15, 19 45  
Was permission obtained from the Conservation Division or its agents before plugging was com-  
menced? Yes.

Name of Conservation Agent who supervised plugging of this well. T.A. Morgan  
Producing formation. Viola Dolomite, Depth to top. 3327 Bottom. 3328 Total Depth of Well. 3328 Feet  
Show depth and thickness of all water, oil and gas formations.

OIL, GAS OR WATER RECORDS,

CASING RECORD

Formation	Content	From	To	Size	Put In	Pulled Out
Viola Dolomite	Oil&Water	3327	3328	5 $\frac{1}{2}$ "OD.	3327	2277'
Perforated 5 $\frac{1}{2}$ "OD. Pipe	Water	3004	3035			
"	Water	2664	2681			

Describe in detail the manner in which the well was plugged, indicating where the mud fluid was placed and the method or methods used in introducing it into the hold. If cement or other plugs were used, state the character of same and depth placed, from \_\_\_\_\_ feet to \_\_\_\_\_ feet for each plug set.

Viola Dolomite Cemented with dump bailer 50' from 3328 to 3278  
Mississippi Lime " " " " 75' from 2975 to 3050  
Kansas City Limestone " " " " 35' from 2650 to 2685

Mud between 3278, 3050, and 2685  
Mud bucketed into surface pipe 143 feet.  
Five sacks of cement in bottom of surface pipe.  
Mud to 15' of the top. Cemented to top.  
Welded cap on surface pipe.



(If additional description is necessary, use BACK of this sheet)

Correspondence regarding this well should be addressed to. Prunty Production Co,  
Address. Ponca, City Okla,

STATE OF \_\_\_\_\_, COUNTY OF \_\_\_\_\_, ss.  
\_\_\_\_\_, (employee of owner) or (owner or operator), of the above-described well,  
being first duly sworn on oath, says: That I have knowledge of the facts, statements, and matters herein contained and the log of the above-  
described well as filed and that the same are true and correct. So help me God.

(Signature) J H Walker

(Address) January 1946

SUBSCRIBED AND SWORN to before me this 25th day of

My commission expires June 10th 1946

Notary Public.