

STATE OF KANSAS
STATE CORPORATION COMMISSION

Form CP-4

WELL PLUGGING RECORD

Give All Information Completely
Make Required Affidavit
Mail or Deliver Report to:
Conservation Division
State Corporation Commission
211 No. Broadway
Wichita, Kansas

Ford County, Sec. 9 Twp. 27S Rge. 21 (E) (W)X

Location as "NE/CNW/SW" or footage from lines Center of SW SW

Lease Owner Mull Drilling Company, Inc.

Lease Name Trimpa Well No. 1

Office Address P. O. Box 972 Pratt, Kansas

Character of Well (completed as Oil, Gas or Dry Hole)

Date well completed 19

Application for plugging filed 6-10-64 19

Application for plugging approved 6-11-64 19


Plugging commenced 6-20-64 19

Plugging completed 7-11-64 19

Reason for abandonment of well or producing formation Dry

If a producing well is abandoned, date of last production 19

Was permission obtained from the Conservation Division or its agents before plugging was commenced? Yes

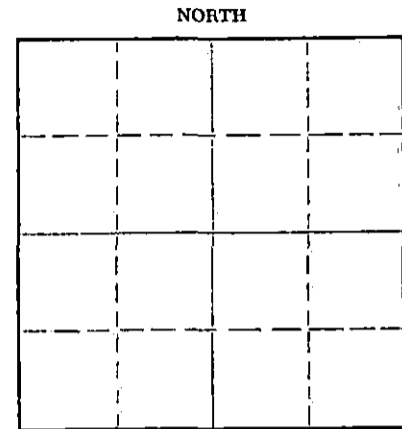

Locate well correctly on above Section Plat

Name of Conservation Agent who supervised plugging of this well Hugh E. Scott

Producing formation Depth to top Bottom Total Depth of Well 5062 Feet

Show depth and thickness of all water, oil and gas formations.

OIL, GAS OR WATER RECORDS

CASING RECORD

FORMATION	CONTENT	FROM	TO	SIZE	PUT IN	PULLED OUT
				8 5/8	293	None
				4 1/2	None	2021

Describe in detail the manner in which the well was plugged, indicating where the mud fluid was placed and the method or methods used in introducing it into the hole. If cement or other plugs were used, state the character of same and depth placed, from feet to feet for each plug set.

Pumped plug and 20 sacks of cement to 4550'. Cleaning out collar. Working pipe. Put in 30' of sand. Loaded hole with water.

Working pipe. Shot pipe at 4400'. Circulating. Spotted 80 bbl. of oil.

Working pipe. Shot pipe at 3000' - 2500' - 2000' - 2100' & 2010'. Pulling pipe.

Pumped 25 sacks of cement to 700'. Pumped 25 sacks of cement at 290'. Dumped 15 sacks on top. Cleaning and doping threads. Moved off location.

RECEIVED
STATE CORPORATION COMMISSION

JUL 22 1964

Name of Plugging Contractor Forbes Casing Pulling, Inc. (If additional description is necessary, use BACK of this sheet)
Address P. O. Box 221 Great Bend, Kansas
Wichita, Kansas CONSERVATION DIVISION

STATE OF Kansas, COUNTY OF Barton, ss. I. O. Forbes (employee of owner) or (owner or operator) of the above-described well, being first duly sworn on oath, says: That I have knowledge of the facts, statements, and matters herein contained and the log of the above-described well as filed and that the same are true and correct. So help me God.

(Signature) I. O. Forbes
P. O. Box 221 Great Bend, Kansas (Address)

SUBSCRIBED AND SWORN TO before me this 21 day of July, 19 64

My commission expires May 27, 1965 Notary Public.

R O T A R Y D R I L L E R S L O G

COMPANY: Mull Drilling Company, Inc. ROTARY DRILLING COMMENCED: 9/22/62
Wichita, Kansas
CONTRACTOR: Mull Drilling Company, Inc. ROTARY DRILLING COMPLETED:
Wichita, Kansas

CASING RECORD: Set 293' of 8 5/8" w/225 sks. LOCATION: TRIMPA #1
Set 4 1/2" casg. @ 5061' w/100 sks. C SW SW 9-27E-21W
Ford County, Kansas

(Figures indicate bottom of formation - measurements from top of Rotary Bushing)

30' Surface Sand
190' Foot Rock & Shale
210' Sand
395' Gray Shale
515' Blue shale & sand
1400' Shale
1450' Anhydrite
2728' Shale
3162' Lime & Shale
3500' Sandy Lime & Shale
4596' Lime & Shale
4650' Lime
4744' Lime & Shale
4787' Lime
4882' Lime & Shale
4895' Lime
4928' Lime & Shale
4938' Cherty Lime & Shale
4948' Cherty Lime & Miss.
4958' Miss.
5062' Miss. Dolomite and Total Depth

RECEIVED
STATE CORPORATION COMMISSION

JUL 27 1964

CONSERVATION DIVISION
Wichita, Kansas

I hereby certify that this is a true and correct copy of the above log to the best of my knowledge.

MULL DRILLING CO., INC.

Joseph B. Brungardt, Jr.
Joseph B. Brungardt, Jr.
Assistant Treasurer

STATE OF KANSAS)
COUNTY OF SEDGWICK) SS

Subscribed and sworn to before me this 22nd day of October, 1962.

Lola L. Foster
Lola L. Foster
Notary Public

My Commission expires: April 17, 1966

