


STATE OF KANSAS  
STATE CORPORATION COMMISSION

WELL PLUGGING RECORD

Give All Information Completely  
Make Required Affidavit  
Mail or Deliver to  
Conservation Division  
State Corporation Commission  
245 North Water  
Wichita, KS 67202

Ford County, Sec. 21 Twp. 27 Rge. 21W E/W  
Location as "NE/CNW $\frac{1}{4}$ SW $\frac{1}{4}$ " or footage from lines  
Sw SW  
Lease Owner Imperial Oil Company  
Lease Name Madison Well No. 1  
Office Address 720 Fourth Financial Center, Wichita 67202  
Character of Well (Completed as Oil, Gas or Dry Hole)  
Dry Hole  
Date Well completed 9/23/76 19  
Application for plugging filed 9/23/76 19  
Application for plugging approved 9/23/76 19  
Plugging commenced 9/23/76 19  
Plugging completed 9/23/76 19  
Reason for abandonment of well or producing formation

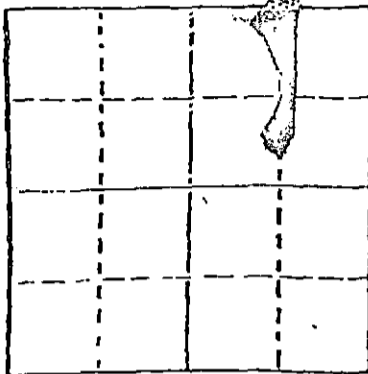

Locate well correctly on above Section Plat

If a producing well is abandoned, date of last production 19

Was permission obtained from the Conservation Division or its agents before plugging was commenced? Yes

Name of Conservation Agent who supervised plugging of this well Clarence Thomas Jr.  
Producing formation Depth to top Bottom Total Depth of Well 5035'  
Show depth and thickness of all water, oil and gas formations.

OIL, GAS OR WATER RECORDS

CASING RECORD

FORMATION	CONTENT	FEET	TO	DATE	PUT IN	PULLED OUT
	Surface	0	403	8-5/8	yes	no

Describe in detail the manner in which the well was plugged, indicating where the mud fluid was placed and the method or methods used in introducing it into the hold. If cement or other plugs were used, state the character of same and depth placed, from feet to feet for each plug set.

Bottom Plug at 500' with 50 sacks 50-50 Poz  
Middle plug @ 300' with 25 sacks 50-50 Poz  
Top and bridge @ 40' with 10 sacks 50-50 Poz  
2 sacks in rathole  
Complete @ 7:00 a.m. 9/23/76

RECEIVED  
STATE CORPORATION COMMISSION  
OCT 01 1976 10-1-76  
CONSERVATION DIVISION  
Wichita, Kansas

(If additional description is necessary, use BACK of this sheet)

Name of Plugging Contractor Slawson Drilling Company, Inc., 408 One Twenty Building, Wichita, Kansas 67202

STATE OF Kansas COUNTY OF Ford


(employee of owner) or (owner or operator) of the above-described well, being first duly sworn on oath, says: That I have knowledge of the facts, statements, and matters herein contained and the log of the above-described well as filed and that the same are true and correct. So help me God.

(Signature) James C. Remsburg  
James C. Remsburg  
408 One Twenty Building, Wichita 67202

Subscribed and sworn to before me this 30 day of September 1976

My commission expires January 17, 1977

Mary Lou Taylor  
Mary Lou Taylor Notary Public

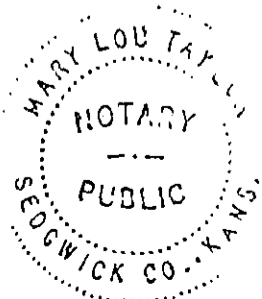

DRILLERS LOG

COMPANY: Imperial Oil Company  
720 Fourth Financial Center  
Wichita, Kansas 67202

LEASE NAME: Madison 1  
SW SW 21-27S-21W  
Ford County, Kansas

CONTRACTOR: Slawson Drilling Company, Inc.  
408 One Twenty Building  
Wichita, Kansas 67202

COMMENCED: 9/13/76

COMPLETED: 9/23/76

TOTAL DEPTH 5035'

CASING: 396.02' set at 403' of new 8-5/8" with 275 sx cement

0' to 80' 12 1/2" Surface Hole - Sand & Yellow clay at 63'  
80' to 630' 12 1/2" surface hole  
630' to 745' Red Bed  
745' to 2583' Shale & Shells  
1342' to 1385' Anhydrite  
2583' to 4615' Lime & Shale  
4615' to 4906' Lime  
4906' to 4945' Lime & Shale  
4945' to 4955' Lime  
4955' to 5035' Mississippian  
5035' RTD

RECEIVED  
OCT 01 1976  
CONSERVATION DIVISION

STATE OF KANSAS

COUNTY OF SEDGWICK

I, James C. Remsberg, of the Slawson Drilling Company, Inc.  
upon oath state that the above and foregoing is a true and correct copy of the  
log of the Madison No.1 well.

*James C. Remsberg*  
James C. Remsberg

Subscribed and sworn to me on September 30, 1976

*Mary Lou Taylor*  
Mary Lou Taylor, Notary

My commission expires January 17, 1977

