


STATE OF KANSAS  
STATE CORPORATION COMMISSION

WELL PLUGGING RECORD

Give All Information Completely  
Make Required Affidavit  
Mail or Deliver Report to:  
Conservation Division  
State Corporation Commission  
800 Bitting Building  
Wichita, Kansas

Ford County, Sec. 27 Twp. 27S Rge. 21 XBX (W)  
Location as "NE/CNW/SW" or footage from lines 6 SE/4 of SE/4  
Lease Owner J. M. Huber Corp.  
Lease Name Young Well No. 1  
Office Address Box 978, Liberal, Kansas  
Character of Well (completed as Oil, Gas or Dry Hole) Dry hole  
Date well completed 8-8-55 19  
Application for plugging filed 8-8-55 19  
Application for plugging approved 8-8-55 19  
Plugging commenced 8-8-55 19  
Plugging completed 8-8-55 19  
Reason for abandonment of well or producing formation Dry Hole

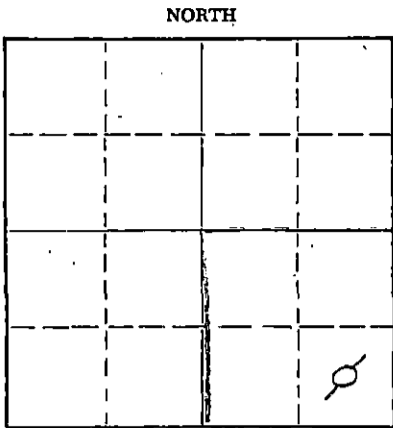

Locate well correctly on above  
Section Plat

If a producing well is abandoned, date of last production \_\_\_\_\_ 19\_\_\_\_  
Was permission obtained from the Conservation Division or its agents before plugging was com-  
menced? yes

Name of Conservation Agent who supervised plugging of this well M. A. Rives  
Producing formation \_\_\_\_\_ Depth to top \_\_\_\_\_ Bottom \_\_\_\_\_ Total Depth of Well 5060' Feet  
Show depth and thickness of all water, oil and gas formations.

OIL, GAS OR WATER RECORDS

CASING RECORD

FORMATION	CONTENT	FROM	TO	SIZE	PUT IN	PULLED OUT
				8-5/8"	535'	None

Describe in detail the manner in which the well was plugged, indicating where the mud fluid was placed and the method or methods used in introducing it into the hole. If cement or other plugs were used, state the character of same and depth placed, from \_\_\_\_\_ feet to \_\_\_\_\_ feet for each plug set.

Filled hole with mud. Pushed Halliburton plug to 525'. Cemented through drill pipe with 35 sacks cement. Pushed plug to 35'. Cemented to surface with 15 sacks cement.

RECEIVED  
STATE CORPORATION COMMISSION  
AUG 23 1955 8-23-55  
CONSERVATION DIVISION  
Wichita, Kansas

(If additional description is necessary, use BACK of this sheet)  
Name of Plugging Contractor Graham-Messman-Rinehart Drilling Co.  
Address 1005 E. 2nd, Wichita, Kansas

STATE OF KANSAS, COUNTY OF SEWARD, ss.  
W. W. Henson (employee of owner) or (owner/operator) of the above-described well, being first duly sworn on oath, says: That I have knowledge of the facts, statements, and matters herein contained and the log of the above-described well as filed and that the same are true and correct. So help me God.

(Signature) W. W. Henson  
Box 978, Liberal, Kansas  
(Address)

SUBSCRIBED AND SWORN to before me this 22 day of August, 19 55

My commission expires 7-27-57

J. R. Kepler  
Notary Public.

PLUGGING  
FILE SEC 27 T 27 R 21 W  
BOOK PAGE 141 LINE 23

NO. 1 YOUNG

WELL RECORD

Location: Ctr SE/4 SE/4, 27-27-21W  
Ford County, Kansas

Commenced: July 22, 1955

Operator: J. M. Huber Corporation  
302 Petroleum Building, Wichita, Kansas

Completed: August 8, 1955

Elevation: 2332 KB

Contractor: Graham-Messman-Rinehart Drilling Co.  
1005 East Second, Wichita, Kansas

Production: D&A

Casing Record: 8 5/8" @ 535' w/300 sacks cement

.....L O G.....

Sand	35
Red Bed-Shale	360
Shale-Red Bed-Gyp	965
Red Bed-Shale	1235
Shale	1612
Red Bed-Shale-Gyp	2110
Shale-Lime	2900
Lime-Shale	3041
Shale-Lime	3190
Shale	3395
Lime-Shale	3516
Shale-Lime	3844
Lime-Shale	3944
Shale-Lime	4087
Lime-Shale	4303
Shale-Lime	4340
Lime	4435
Shale-Lime	4500
Lime	4575
Sand-Lime	4590
Lime	4617
Lime	4916
Core #1	4966
Core #2	5005
Lime	5060 R.T.D.

Log Tops:

Brown Lime 4262 (-1930)  
Lansing 4271 (-1939)  
Mississippi 4908 (-2576)

The undersigned, GRAHAM-MESSMAN-RINEHART DRILLING COMPANY, hereby certifies that the above log is a true and correct log of the formation encountered in drilling the above well as reflected by the Daily Drilling Report.

GRAHAM-MESSMAN-RINEHART DRILLING COMPANY

By: Roger L. Messman  
Roger L. Messman

Subscribed and sworn to before me  
this 12th day of August 1955.

Juanita L. Lewis  
Notary Public

My Commission Expires: November 5, 1958  
STATE CORPORATION COMMISSION

AUG 23 1955

CONSERVATION DIVISION  
Wichita, Kansas

**PLUGGING**  
FILE SEC 27-27-21W  
BOOK PAGE 144 LINE 33