


STATE OF KANSAS
STATE CORPORATION COMMISSION

Give All Information Completely
Make Required Affidavit
Mail or Deliver Report to:
Conservation Division
State Corporation Commission
800 Bittling Building
Wichita, Kansas

WELL PLUGGING RECORD

NORTH

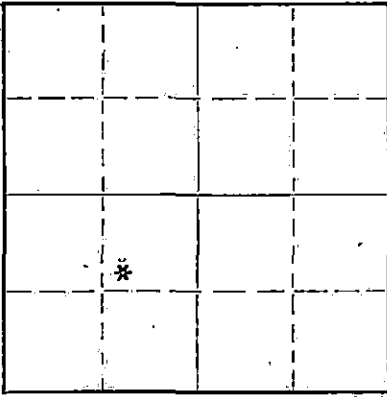

Locate well correctly on above
Section Plat

Ford County. Sec. 35 Twp. 27 Rge. 21 (E) W (W)
Location as "NE/CNW $\frac{1}{4}$ SW $\frac{1}{4}$ " or footage from lines SW NE SW
Lease Owner Panhandle Eastern Pipe Line Co.
Lease Name Birney Well No. #1-35
Office Address PO Box 979, Liberal, Kansas
Character of Well (completed as Oil, Gas or Dry Hole) Dry Hole
Date well completed January 19 51
Application for plugging filed September 30 19 52
Application for plugging approved October 1 19 52
Plugging commenced October 3 19 52
Plugging completed October 5 19 52
Reason for abandonment of well or producing formation Dry Hole

If a producing well is abandoned, date of last production 19
Was permission obtained from the Conservation Division or its agents before plugging was commenced? Yes

Name of Conservation Agent who supervised plugging of this well R. J. Phillippe
Producing formation None Depth to top - Bottom - Total Depth of Well 5015 Feet
Show depth and thickness of all water, oil and gas formations.

OIL, GAS OR WATER RECORDS

CASING RECORD

Formation	Content	From	To	Size	Put In	Pulled Out
No drilling log available				8 5/8"	329	None
				5 1/2"	5015	2555

Describe in detail the manner in which the well was plugged, indicating where the mud fluid was placed and the method or methods used in introducing it into the hole. If cement or other plugs were used, state the character of same and depth placed, from feet to feet for each plug set.

When this well was purchased by Panhandle Eastern Pipe Line Co., the well had been plugged with cement from 5015 to 4910 feet.

- Drilling mud from 4910' to 1,500'
- Cement plug from 1,500' to 1,408'
- Drilling mud from 1,408' to 300'
- Cement plug from 300' to 266'
- Drilling mud and sand from 266' to 42'
- Cement plug from 42' to 8'

The surface pipe was cut off at the bottom of the cellar and the cellar filled in.

(If additional description is necessary, use BACK of this sheet)

Correspondence regarding this well should be addressed to Mr. L. W. Phillips
Address PO Box 979 Liberal, Kansas

STATE OF Kansas, COUNTY OF Seward, ss.
Jack P. Phillippe (employee of owner) or (owner or operator) of the above-described well,
being first duly sworn on oath, says: That I have knowledge of the facts, statements, and matters herein contained and the log of the above-described well as filed and that the same are true and correct. So help me God.

(Signature) Jack P. Phillippe
PO Box 979, Liberal, Kansas
(Address)

SUBSCRIBED AND SWORN to before me this 15 day of October, 19 52

S. S. Blair Notary Public.

My commission expires MY COMMISSION EXPIRES DEC. 9, 1953

PLUGGING
FILE SEC 35 T 27 R 24
BOOK PAGE 42 LINE 2

10-18-52
CONSERVATION DIVISION
Wichita, Kansas