


STATE OF KANSAS
STATE CORPORATION COMMISSION

WELL PLUGGING RECORD

Give All Information Completely
Make Required Affidavit
Mail or Deliver Report to:
Conservation Division
State Corporation Commission
211 No. Broadway
Wichita, Kansas

Ford County, Sec. 13 Twp. 27S Rge. (E) 23 (W)
Location as "NE/CNW/SW" or footage from lines C SE/4 NW/4
Lease Owner Aikman Brothers
Lease Name Campbell English Well No. 1
Office Address 601 Midland National Bank Building, Midland, Texas
Character of Well (completed as Oil, Gas or Dry Hole) Dry Hole
Date well completed December 31 19 60
Application for plugging filed December 31 19 60
Application for plugging approved December 31 19 60
Plugging commenced January 1 19 61
Plugging completed January 1 19 61
Reason for abandonment of well or producing formation Dry Hole

NORTH

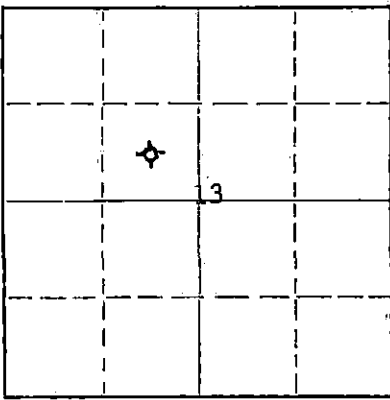

Locate well correctly on above
Section Plat

If a producing well is abandoned, date of last production 19
Was permission obtained from the Conservation Division or its agents before plugging was commenced? Yes

Name of Conservation Agent who supervised plugging of this well Merle A. Rives
Producing formation none Depth to top Bottom Total Depth of Well 5220 Feet
Show depth and thickness of all water, oil and gas formations.

OIL, GAS OR WATER RECORDS

CASING RECORD

FORMATION	CONTENT	FROM	TO	SIZE	PUT IN	PULLED OUT
				8 5/8"	18 jts @ 557'	none

Describe in detail the manner in which the well was plugged, indicating where the mud fluid was placed and the method or methods used in introducing it into the hole. If cement or other plugs were used, state the character of same and depth placed, from feet to feet for each plug set.

Plug at 500' with 25 sx cement. Mud to 40'. Plug and 10 sx cement on top.

RECEIVED
STATE CORPORATION COMMISSION
1-17-61
JAN 17 1961
CONSERVATION DIVISION
Wichita, Kansas

(If additional description is necessary, use BACK of this sheet)

Name of Plugging Contractor Graham-Michaelis Drilling Company
Address 211 North Broadway, Wichita 2, Kansas

STATE OF Kansas, COUNTY OF Sedgwick, ss.
W. A. Michaelis (employee of owner) of the above-described well, being first duly sworn on oath, says: That I have knowledge of the facts, statements, and matters herein contained and the log of the above-described well as filed and that the same are true and correct. So help me God.

(Signature) W. A. Michaelis (Graham-Michaelis Drig. Co.)
211 North Broadway, Wichita 2, Kansas
(Address)

SUBSCRIBED AND SWORN to before me this 16th day of January, 19 61

A. B. Barga
A. B. Barga Notary Public.



CAMPBELL-ENGLISH #1

WELL RECORD:

LOCATION:

SE NW Section 13-27-23

Commenced: 12/14/60
Completed: 12/31/60
(Rotary)

CONTRACTOR:

Graham-Michaelis Drilling Co.
Liberal Division
Box 896
Liberal, Kansas

CASING RECORD:

18 Jts. 8 5/8" J-55 8rd Thrd R-2
Cemented w/150 sx Common 2% Gel
2% cc followed w/200 sx Sunset

	LOG	
Soil & Gyp	0 -	134
Blue Shale & Sand	134 -	344
Blue Shale	344 -	685
Shale, Red Bed & Gyp	685 -	2030
Shale & Anhy	2030 -	2549
Lime & Shale	2549 -	2708
Shale, Anhy & Chert	2708 -	2808
Shale, Anhy & Lime	2808 -	2896
Lime & Shale	2896 -	3039
Shale, Lime & Chalk	3039 -	3644
Lime & Shale	3644 -	3880
Shale, Lime & Chalk	3880 -	4003
Lime & Shale	4003 -	4887
Lime, Shale & Chert	4887 -	4941
Shale & Lime	4941 -	5018
Lime & Chert	5018 -	5097
Lime	5097 -	5125
Lime & Chert	5125 -	5160
Lime	5160 -	5220

RECEIVED
STATE CORPORATION COMMISSION

JUN 9 8 1962

CONSERVATION DIVISION
Wichita, Kansas

5220' - Total Rotary Depth

The undersigned, Graham-Michaelis Drilling Company, Liberal Division, certifies that the above log is a true and correct copy of the formations encountered in drilling the above mentioned well, as taken from the Daily Drilling Report.

GRAHAM-MICHAELIS DRILLING COMPANY
LIBERAL DIVISION

By H. R. Michaelis
H. R. Michaelis