


5-155-20962-0000

WELL PLUGGING RECORD

Give All Information Completely
 Make Required Affidavit

COUNTY Reno SEC. 16 TWP. 26S RGE. 4W E/W
 Location as in quarters or footage from lines:
NE/4 SW/4 NE/4

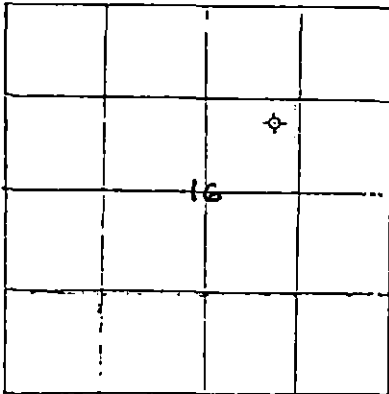

Locate Well
 correctly on above
 Section Platt.

Lease Owner Olympic Petroleum Company
 Lease Name Hilger Well No. 1
 Office Address 2121 South Columbia Avenue, Tulsa, Okla. 74114
 Character of Well (Completed as Oil, Gas or Dry Hole): Dry Hole
 Date Well Completed December 16, 1983
 Application for plugging filed December 16, 1983
 Plugging commenced December 16, 1983
 Plugging completed December 16, 1983
 Reason for abandonment of well or producing formation D & A

Was permission obtained from the Conservation Division or it's
 Agent's before plugging was commenced? _____

Name of Conservation Agent who supervised plugging of this well _____

Producing formation _____ Depth to top _____ bottom T.D. 4,105'

Show depth and thickness of all water, oil and gas formations.

OIL, GAS OR WATER RECORDS Casing Record

Formation	Content	From	To	Size	Put in	Pulled Out
				8 5/8"	297.22'	-0-

Describe in detail the manner in which the well was plugged, indicating where the mud
 fluid was placed and the method or methods used in introducing it into the hold. If cement
 or other plugs were used, state the character of same and depth placed, from _____ feet
 to _____ feet for each plug set.

Plugged hole @ 800' w/35 sx cement
 @ 350' w/35 sx cement
 @ 60' w/25 sx cement

10 sx cement in rathole
 Plug did not hold

Cemented w/35 sx cement, 6% Gel, 3% C.C.
 @ 47' to Top of Surface.

(If additional description is necessary, use BACK of this sheet)

Name of Plugging Contractor _____

STATE OF Oklahoma COUNTY OF Tulsa, ss.


 (employee of owner) or (owner or operator) of the
 above-described well, being first duly sworn on oath, says: That I have knowledge of the
 facts, statements, and matters herein contained and the log of the above-described well as
 filed and that the same are true and correct. So help me God.

(Signature) James L. Delver

(Address) _____

SUBSCRIBED AND SWORN TO before me this 12th day of January, 1984

South M. Seader
 Notary Public.

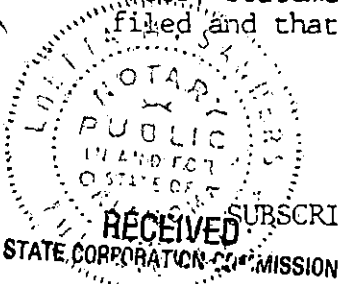

JAN 13 1984

Commission expires: 8-28-86