

15-155-66054-0000

STATE OF KANSAS - STATE CORPORATION COMMISSION


WELL PLUGGING RECORD

Give All Information Completely Make Required Affidavit Mail or Deliver Report to: Conservation Division State Corporation Commission 800 Bitting Building Wichita, Kansas

OR FORMATION PLUGGING RECORD

Strike out upper line when reporting plugging off formations.

Reno County. Sec. 29 Twp. 26 Rge. 4 (E) (W) Location as "NE 1/4 NW 1/4 SW 1/4" or footage from lines NW NE Lease Owner: The Kingwood Oil Company Lease Name: J. J. Hilger Office Address: Effingham, Illinois Character of Well (completed as Oil, Gas or Dry Hole): Dry hole Date well completed: April 23, 1945 Application for plugging filed: April 24, 1945 Application for plugging approved: April 24, 1945 Plugging commenced: April 24, 1945 Plugging completed: April 24, 1945 Reason for abandonment of well or producing formation:

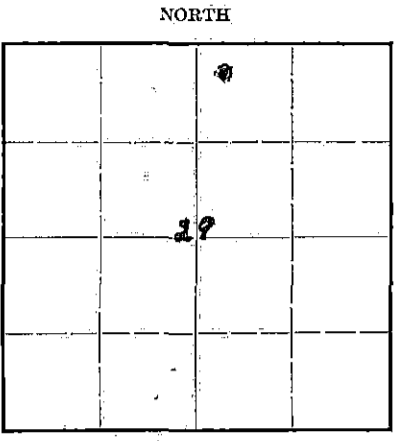

Locate well correctly on above Section Plat

If a producing well is abandoned, date of last production: 19 Was permission obtained from the Conservation Division or its agents before plugging was commenced? Yes

Name of Conservation Agent who supervised plugging of this well: Durkee Producing formation: Depth to top: Bottom: Total Depth of Well: 4210 Feet Show depth and thickness of all water, oil and gas formations.

OIL, GAS OR WATER RECORDS


CASING RECORD

Table with 7 columns: Formation, Content, From, To, Size, Put In, Pulled Out. Row 1: 10 3/4", 310', None

Describe in detail the manner in which the well was plugged, indicating where the mud fluid was placed and the method or methods used in introducing it into the hold. If cement or other plugs were used, state the character of same and depth placed, from feet to feet for each plug set.

Filled with heavy mud from 4210 to bottom of surface pipe - Set bridge at 250' and cemented with 15 sacks - set bridge at 15' and cemented with 5 sacks.

5-7-45

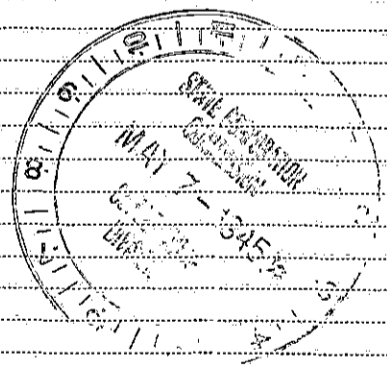

PLUGGING FILE 29 26 40 BOOK PAGE 10 LINE 40

(If additional description is necessary, use BACK of this sheet) Correspondence regarding this well should be addressed to: The Kingwood Oil Company Address: Effingham, Illinois

STATE OF KANSAS COUNTY OF SEDGWICK Perry R. Hanson (employee of owner) or (owner or operator) of the above-described well,

being first duly sworn on oath, says: That I have knowledge of the facts, statements, and matters herein contained and the log of the above-described well as filed and that the same are true and correct. So help me God. THE PHIL-HAN OIL COMPANY

(Signature) Perry R. Hanson (Address)

SUBSCRIBED AND SWORN to before me this 2nd day of May 1945. Notary Public.

My commission expires October 4, 1945.