

15-035-30 196-0000

Form CP-4


STATE OF KANSAS
STATE CORPORATION COMMISSION

Give All Information Completely
Make Required Affidavit
Mail or Deliver Report to:
Conservation Division
State Corporation Commission
511 N. Broadway
Wichita, Kansas

WELL PLUGGING RECORD

Cowley County, Sec. 8 Twp. 33 Rgs. 4 (E) (W)

Location as "NE/CNWSW" or footage from lines NW/4 SE/4 NW/4
Lease Owner George R. McNeish Oil Operations
Lease Name Goodnight Well No. 1
Office Address 524 State Bank Bldg. - Winfield, Kansas
Character of Well (completed as Oil, Gas or Dry Hole) Dry Hole
Date well completed 7/12 19 66
Application for plugging filed 7/12 19 66
Application for plugging approved 7/12 19 66
Plugging commenced 7/12 19 66
Plugging completed 7/12 19 66
Reason for abandonment of well or producing formation _____

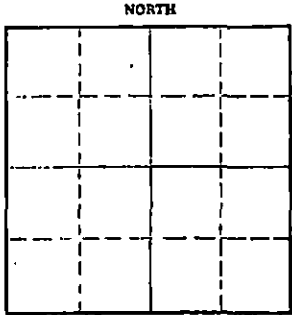

Locate well correctly on above Section Plat

If a producing well is abandoned, date of last production _____ 19____
Was permission obtained from the Conservation Division or its agents before plugging was commenced? _____

Name of Conservation Agent who supervised plugging of this well H. E. Hess
Producing formation _____ Depth to top _____ Bottom _____ Total Depth of Well 3290 Feet
Show depth and thickness of all water, oil and gas formations.

OIL, GAS OR WATER RECORDS

CASING RECORD

FORMATION	CONTENT	FROM	TO	SIZE	PUT IN	PULLED OUT

Describe in detail the manner in which the well was plugged, indicating where the mud fluid was placed and the method or methods used in introducing it into the hole. If cement or other plugs were used, state the character of same and depth placed, from _____ feet to _____ feet for each plug set.

Plug @ 225' with $\frac{1}{2}$ sack hulls - 20 sacks cement mud to 35'
- $\frac{1}{2}$ sack hulls - Plug - cement to surface.

RECEIVED
STATE CORPORATION COMMISSION
JUL 18 1966
CONSERVATION DIVISION
Wichita, Kansas

7-18-66

(If additional description is necessary, use BACK of this sheet)
Name of Plugging Contractor Watson Drilling Co., Inc.
Address 502 State Bank Bldg. - Winfield, Kansas

STATE OF Kansas COUNTY OF Cowley ss.
Joe R. Everly (employee of owner) or (owner or operator) of the above-described well, being first duly sworn on oath, says: That I have knowledge of the facts, statements, and matters herein contained and the log of the above-described well as filed and that the same are true and correct. So help me God.

(Signature) [Signature]
Winfield, Kansas
(Address)

SUBSCRIBED AND SWORN to before me this 14th day of July, 1966

My commission expires May 15, 1969 Norma Beard Notary Public.

8-33-4K

15-035-30196-0000

KOTARY DRILLING LOG

OWNER: George E. McNich Oil Operators
524 State Bank Building
Wichita, Kansas

Lease: GOODRIGHT #1

CONTRACTOR: Watson Drilling Co., Inc.
528 State Bank Building
Wichita, Kansas

Location: NW/4 30/4 NW/4 -
Sec. 8-30-4
Covey County, Kansas

Commenced: 7/5/66
Completed: 7/12/66

Cip. log 20' of 2 1/2" casing attached
with 140 rods cement.

0	20	Surface clay

RECEIVED
STATE CORPORATION COMMISSION
JUL 20 1966
CONFIRMATION DIVISION
Wichita, Kansas

Plugged with mud to 25' in 2"
well, including 25' in cement
and to 15' in 1 1/2" hole
cement in casing.

T.D.

We certify that the above log is true and correct
to the best of our knowledge and belief.

WATSON DRILLING CO., INC.

By: *[Signature]*