


STATE OF KANSAS  
STATE CORPORATION COMMISSION  
CONSERVATION DIVISION  
P. O. BOX 17027  
WICHITA, KANSAS 67217

FORM CP-4

WELL PLUGGING RECORD

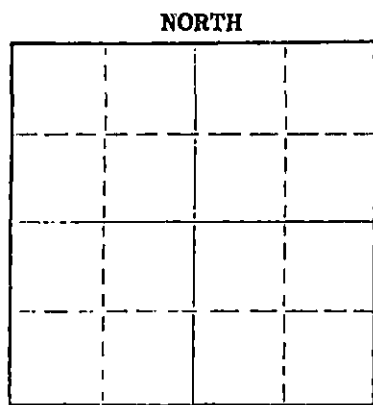

Locate well correctly on above Section Plat

Kiowa County, Sec. 34 Twp. 27S Rgc. (E) 20 (W)  
Location as "NE/CNWSW" or footage from lines C SW SW  
Lease Owner Petroleum, Inc.  
Lease Name McFadden "E" Well No. 1  
Office Address Route 2, Great Bend, Kansas 67530  
Character of Well (completed as Oil, Gas or Dry Hole) Dry Hole  
Date well completed September 22, 1976  
Application for plugging filed September 21, 1976  
Application for plugging approved September 21, 1976  
Plugging commenced September 22, 1976  
Plugging completed September 22, 1976  
Reason for abandonment of well or producing formation Dry

If a producing well is abandoned, date of last production 19\_\_\_\_  
Was permission obtained from the Conservation Division or its agents before plugging was commenced? Yes

Name of Conservation Agent who supervised plugging of this well Russel Beyerstein  
Producing formation \_\_\_\_\_ Depth to top \_\_\_\_\_ Bottom \_\_\_\_\_ Total Depth of Well \_\_\_\_\_ feet  
Show depth and thickness of all water, oil and gas formations.

OIL, GAS OR WATER RECORDS

CASING RECORD

FORMATION	CONTENT	FROM	TO	SIZE	PUT IN	FULLED OUT
		0	605	8 5/8	597.09	None

Describe in detail the manner in which the well was plugged, indicating where the mud fluid was placed and the method or methods used in introducing it into the hole. If cement or other plugs were used, state the character of same and depth placed, from \_\_\_\_\_ feet to \_\_\_\_\_ feet for each plug set.

Plugged: 35 sacks @ 300'; mud 40'  
plug 1/2 sack hulls 15 sacks base of cellar  
Sun Cementing  
Plug down 12:00 noon on 9-22-76

RECEIVED  
STATE CORPORATION COMMISSION

OCT 01 1976

CONSERVATION DIVISION  
Wichita, Kansas

(If additional description is necessary, use BACK of this form)  
Name of Plugging Contractor DaMac Drilling, Inc.  
Address Box 1164, Great Bend, Kansas 67530

STATE OF Kansas COUNTY OF Barton ss.  
Martha J. McKown (employee of owner) or (owner or operator) of the above-described well, being first duly sworn on oath, says: That I have knowledge of the facts, statements, and matters herein contained and the log of the above-described well as filed and that the same are true and correct. So help me God.

DONALD SLOUP  
STATE NOTARY PUBLIC  
Barton County, Kansas  
My Commission Expires November 11, 1978

(Signature) Martha J. McKown

Box 1164, Great Bend, Kansas 67530  
(Address)

29th day of September 1976

My commission expires 11-11-78

Donald Sloup  
Notary Public

**KANSAS DRILLERS LOG**

S. 34 T. 27S R. 20W E

API No. 15 \_\_\_\_\_  
County \_\_\_\_\_ Number \_\_\_\_\_

Loc. C SW SW


Operator  
Petroleum, Inc.

County Kiowa

Address  
Route 2, Great Bend, Kansas 67530

640 Acres  
N

Well No. 1 Lease Name McFadden "E"

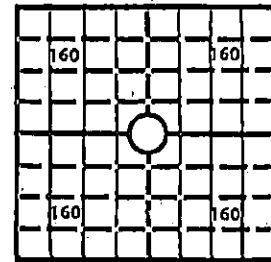

Footage Location  
feet from (N) (S) line \_\_\_\_\_ feet from (E) (W) line \_\_\_\_\_

Principal Contractor DaMac Drilling, Inc. Geologist Gerald Becker

Spud Date September 10, 1976 Total Depth 4905 P.B.T.D. \_\_\_\_\_

Date Completed September 23, 1976 Oil Purchaser \_\_\_\_\_

Elev.: Gr. \_\_\_\_\_

DF \_\_\_\_\_ KB \_\_\_\_\_

**CASING RECORD**

Report of all strings set— surface, intermediate, production, etc.

Purpose of string	Size hole drilled	Size casing set (in O.D.)	Weight lbs/ft.	Setting depth	Type cement	Sacks	Type and percent additives
Surface	12 1/4	8 5/8	20	605	Poz	200	3% CC & 2% Gel
					Reg	200	3% CC & 2% Gel

**LINER RECORD**

**PERFORATION RECORD**

Top, ft.	Bottom, ft.	Sacks cement	Shots per ft.	Size & type	Depth interval

Size	Setting depth	Packer set at

**ACID, FRACTURE, SHOT, CEMENT SQUEEZE RECORD**

Amount and kind of material used	Depth interval treated

RECEIVED  
STATE CORPORATION COMMISSION  
OCT 01 1976  
CONSERVATION DIVISION  
Wichita, Kansas

**INITIAL PRODUCTION**

Date of first production	Producing method (flowing, pumping, gas lift, etc.)
RATE OF PRODUCTION PER 24 HOURS	Oil _____ Gas _____ Water _____ Gas-oil ratio _____
Disposition of gas (vented, used on lease or sold)	Producing interval (s) _____

INSTRUCTIONS: As provided in KCC Rule 82-2-125, within 90 days after completion of a well, one completed copy of this Drillers Log shall be transmitted to the State Geological Survey of Kansas, 4150 Monroe Street, Wichita, Kansas 67209. Copies of this form are available from the Conservation Division, State Corporation Commission, 3830 So. Maridian (P.O. Box 17027), Wichita, Kansas 66217. Phone AC 316-522-2206. If confidential custody is desired, please note Rule 82-2-125. Drillers Logs will be on open file in the Oil and Gas Division, State Geological Survey of Kansas, Lawrence, Kansas 66044.

Petroleum, Inc.

Well No. 1 Lease Name McFadden "E" Dry Hole

S 34 T 27R 20W E W

WELL LOG

Show all important zones of porosity and contents thereof; cored intervals, and all drill-stem tests, including depth interval tested, cushion used, time tool open, flowing and shut-in pressures, and recoveries.

SHOW GEOLOGICAL MARKERS, LOGS RUN, OR OTHER DESCRIPTIVE INFORMATION.

Table with 5 columns: FORMATION DESCRIPTION, CONTENTS, ETC., TOP, BOTTOM, NAME, DEPTH. Rows include Surface Sand, Clay & Shells; Sand & Shale; Shale, Sand, Redbed; Lime & Shale; Lime; Lime & Shale; Lime.

USE ADDITIONAL SHEETS, IF NECESSARY, TO COMPLETE WELL RECORD.

Date Received: [blank] Signature: Martha J. McKown Vice President Title: September 28, 1976 Date