


STATE OF KANSAS
STATE CORPORATION COMMISSION
CONSERVATION DIVISION
P. O. BOX 17027
WICHITA, KANSAS 67217

FORM CP-4

WELL PLUGGING RECORD

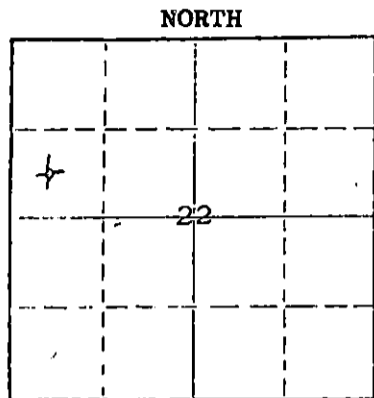

Locate well correctly on above Section Plat

Kiowa County. Sec. 22 Twp 27S Rge. 19W (W)
Location as "NE/CNW&SW" or footage from lines C NW SW
Lease Owner White & Ellis Drilling, Inc.
Lease Name Brensing Well No. 1
Office Address 7701 E. Kellogg, Suite 290, Wichita, Kansas
Character of Well (completed as Oil, Gas or Dry Hole) Dry Hole
Date well completed June 1, 1978
Application for plugging filed June 1, 1978
Application for plugging approved June 1, 1978
Plugging commenced June 1, 1978
Plugging completed June 1, 1978
Reason for abandonment of well or producing formation Dry Hole

If a producing well is abandoned, date of last production _____ 19____
Was permission obtained from the Conservation Division or its agents before plugging was commenced? Yes

Name of Conservation Agent who supervised plugging of this well _____
Producing formation _____ Depth to top _____ Bottom _____ Total Depth of Well 4820 Feet
Show depth and thickness of all water, oil and gas formations.

OIL, GAS OR WATER RECORDS				CASING RECORD		
FORMATION	CONTENT	FROM	TO	SIZE	PUT IN	FULLED OUT
		0'	599'	8-5/8"	591.99'	None

Describe in detail the manner in which the well was plugged, indicating where the mud fluid was placed and the method or methods used in introducing it into the hole. If cement or other plugs were used, state the character of same and depth placed, from _____ feet to _____ feet for each plug set.

Plugged with 600 sacks cement at 600'
10 sacks cement and plug at 40'.
RECEIVED... JUN 10 1978... 6-8-78

(If additional description is necessary, use BACK of this sheet)
Name of Plugging Contractor Halliburton Cementing Co.
Address 410 Union Center, Wichita, Kansas

STATE OF KANSAS COUNTY OF SEDGWICK ss.

John H. Knightley Agent (employee of owner) or (owner or operator) of the above-described well, being first duly sworn on oath, says: That I have knowledge of the facts, statements, and matters herein contained and the log of the above-described well as filed and that the same are true and correct. So help me God.

(Signature) John H. Knightley
221 S. Broadway, Wichita, Kansas
(Address)

SUBSCRIBED AND SWORN TO before me this 7th day of June, 19 78

My commission expires March 12, 1979 Stella J. Lipps Notary Public.

White & Ellis Drilling, Inc. - Brensing #1
C. NW, SW Sec. 22-27S-19W
Kiowa County, Kansas

Contractor: D. R. Lauck Oil Company, Inc.
221 S. Broadway, Suite 400
Wichita, Kansas 67202

Commenced: May 20, 1978
Completed: June 1, 1978

Drillers Log

Sand	154
Blue Shale	466
Sand	498
Blue Shale	602
Red Bed	1030
Shale & Lime	1570
Shale	2370
Shale & Lime	4060
Lime & Shale	4222
Lime	4820 RTD

RECEIVED
STATE CORPORATION COMMISSION
JUN 08 1978
CONSERVATION DIVISION
Wichita, Kansas