

STATE OF KANSAS
STATE CORPORATION COMMISSION


WELL PLUGGING RECORD

Give All Information Completely
Make Required Affidavit
Mail or Deliver Report to:
Conservation Division
State Corporation Commission
800 Bittling Building
Wichita, Kansas

OR
FORMATION PLUGGING RECORD

Strike out upper line
when reporting plug-
ging off formations.

NORTH

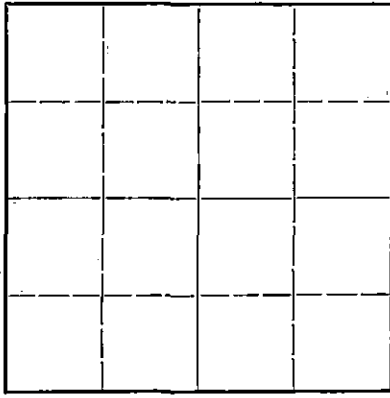

Locate well correctly on above
Section Plat

Kiowa County. Sec. 22 Twp. 27 S Rge. (E) 19 (W)
Location as "NE 1/4 NW 1/4 SW 1/4" or footage from lines 1980' from W. line & 650' from N.
Lease Owner. Viersen & Cochran line of NW 1/4.
Lease Name. W.K.H. Trust Co. Well No. 1
Office Address. P. O. Box 280, Okmulgee, Oklahoma
Character of Well (completed as Oil, Gas or Dry Hole). Dry hole
Date well completed. 8-11 19 44
Application for plugging filed. 10-1 19 44
Application for plugging approved. 10-1 19 44
Plugging commenced. 10-1 19 44
Plugging completed. 10-1 19 44
Reason for abandonment of well or producing formation. Dry hole

If a producing well is abandoned, date of last production. 19
Was permission obtained from the Conservation Division or its agents before plugging was commenced? Yes

Name of Conservation Agent who supervised plugging of this well. Mr. Kerr, Great Bend, Kansas.
Producing formation. _____ Depth to top. _____ Bottom. _____ Total Depth of Well. _____ Feet
Show depth and thickness of all water, oil and gas formations.

OIL, GAS OR WATER RECORDS

CASING RECORD


Formation	Content	From	To	Size	Put In	Pulled Out
Line	Dry	4998	5060	10-3/4"	558'	None
Line	Dry	4186	4445	5" OD	4,445'	2,470'

Describe in detail the manner in which the well was plugged, indicating where the mud fluid was placed and the method or methods used in introducing it into the hold. If cement or other plugs were used, state the character of same and depth placed, from _____ feet to _____ feet for each plug set.

Hole was filled with heavy mud-laden fluid to base of surface string. Cement plug at 550 feet. Balance of hole cemented and plugged in accordance with instructions and regulations.

10-19-44

PLUGGING
FILE # 22 27 19W
BOOK PAGE 132 LINE 30

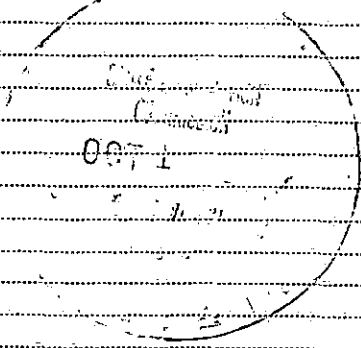

(If additional description is necessary, use BACK of this sheet)

Correspondence regarding this well should be addressed to Viersen & Cochran
Address P. O. Box 280, Okmulgee, Oklahoma

STATE OF OKLAHOMA COUNTY OF OKMULGEE, ss.
J. A. Mock, Agent, (employee of owner) or (owner or operator) of the above-described well,
being first duly sworn on oath, says: That I have knowledge of the facts, statements, and matters herein contained and the log of the above-described well as filed and that the same are true and correct. So help me God.

(Signature) J. A. Mock, Agent

Box 280, Okmulgee, Oklahoma
(Address)

SUBSCRIBED AND SWORN to before me this 17 day of October, 19 44

Frances Moll

Notary Public.

My commission expires April 19, 1945

D R I L L E R ' S L O G

Well: W.K.H. TRUST CO. #1

Commenced drilling: 5-1-44
Completed drilling: 6-15-44

Location: NE $\frac{1}{4}$ NW $\frac{1}{4}$ Section 22-278-19W,
Kiowa County, Kansas.

Total Depth: 5,060 feet.

FORMATION	TOP	BOTTOM	FORMATION	TOP	BOTTOM
Sand	0	165	Lime & chert	4886	4908
Shells and shale	165	608	Shale	4908	4912
Red Bed and shells	608	1330	Broken lime	4912	4975
Shale	1330	1360	Sandy lime & shale	4975	4988
Shale and shells	1360	1690	Shale	4988	4990
Red Bed and shells	1690	2155	Lime & chert	4990	4998
Lime and shale	2155	2380	Lime (soft 5014-18)	4998	5018
Lime and hard shale	2380	2450	Lime & cherty Dolomite	5018	5051
Lime	2450	2465	Lime	5051	5060
Hard, sharp sand	2465	2470	T. D.	5060	
Shale	2470	2500			
Lime and shale	2500	2580			
Lime	2580	2665			
Lime and shale	2665	2755			
Lime	2755	2780			
Lime and shale	2780	3020			
Sandy shale and lime	3020	3090			
Lime and shale	3090	3335			
Shale	3335	3455			
Lime	3455	3510			
Sand	3510	3515			
Lime	3515	3525			
Shale and lime	3525	3545			
Lime	3545	3565			
Shale and lime	3565	3595			
Shale & lime, soft	3595	3620			
Broken shale & lime	3620	3640			
Shale and lime	3640	3720			
Lime	3720	3875			
Lime and shale	3875	3905			
Shale	3905	3935			
Lime and shale	3935	4005			
Lime	4005	4040			
Shale and lime	4040	4187			
Soft lime (Gas odor)	4187	4199			
Hard lime	4199	4222			
Lime	4222	4300			
Shale and lime	4300	4356			
Hard shale and lime	4356	4363			
Soft lime (good odor)	4363	4373			
Lime and shale	4373	4427			
Soft lime (Gas odor)	4427	4435			
Lime and shale	4435	4447			
Lime	4447	4485			
Shale and lime	4485	4575			
Shale and shells	4575	4609			
Shale and lime	4609	4664			
Lime & chert - Miss.	4664	4678			
Lime and shale	4678	4773			
Lime, soft (odor)	4773	4790			
Chert and lime	4790	4857			
Lime and shale	4857	4886			

PLUGGING
FILE 22 27-194
BOOK PAGE 132 LINE 30-

