

STATE OF KANSAS
STATE CORPORATION COMMISSION


Form CP-4

WELL PLUGGING RECORD

Give All Information Completely
Make Required Affidavit
Mail or Deliver Report to:
Conservation Division
State Corporation Commission
211 No. Broadway
Wichita, Kansas

Kiowa County, Sec. 12 Twp. 27S Rge. 20W ~~22E~~ (XX)

NORTH

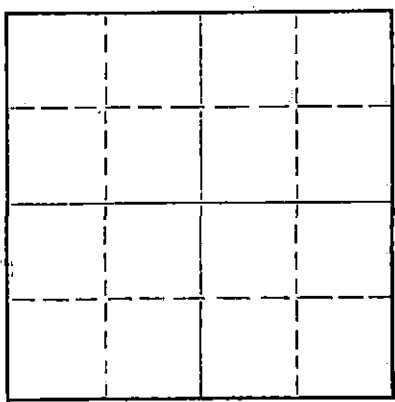

Locate well correctly on above
Section Plat

Location as "NE/CNW%SW%" or footage from lines C SW SW
Lease Owner Jones-Gebert Oil, Inc.
Lease Name Stevens Well No. #1
Office Address 205 Central Bldg.
Character of Well (completed as Oil, Gas or Dry Hole) Dry Hole
Date well completed 3/26/64 19__
Application for plugging filed 3/26/64 19__
Application for plugging approved 3/26/64 19__
Plugging commenced 3/25/64 19__
Plugging completed 3/26/64 19__
Reason for abandonment of well or producing formation Dry Hole

If a producing well is abandoned, date of last production 19__
Was permission obtained from the Conservation Division or its agents before plugging was commenced? Yes

Name of Conservation Agent who supervised plugging of this well Archie V. Elving
Producing formation _____ Depth to top _____ Bottom _____ Total Depth of Well _____ Feet
Show depth and thickness of all water, oil and gas formations.

OIL, GAS OR WATER RECORDS CASING RECORD

FORMATION	CONTENT	FROM	TO	SIZE	PUT IN	PULLED OUT
				8-5/8"	355'	

Describe in detail the manner in which the well was plugged, indicating where the mud fluid was placed and the method or methods used in introducing it into the hole. If cement or other plugs were used, state the character of same and depth placed, from _____ feet to _____ feet for each plug set.
Set plug at 300' with 25 sacks cement,
plug at 40' with 10 sacks cement.

RECEIVED
STATE CORPORATION COMMISSION

4-1-64
APR 1 1964

CONSERVATION DIVISION
Wichita, Kansas

(If additional description is necessary, use BACK of this sheet)

Name of Plugging Contractor Jones-Gebert Oil, Inc.
Address 205 Central Building, Wichita, Kansas

STATE OF Kansas, COUNTY OF Sedgwick, ss.
George R. Jones (employee of owner) or (owner or operator) of the above-described

well, being first duly sworn on oath, says: That I have knowledge of the facts, statements, and matters herein contained and the log of the above-described well as filed and that the same are true and correct. So help me God.

(Signature) [Signature]
205 Central Building, Wichita, Kansas
(Address)

SUBSCRIBED AND SWORN TO before me this 30th day of March, 1964

My commission expires January 8, 1968

[Signature]
Lois J. McCoy Notary Public.

DRILLER'S LOG

Company: Jones-Gebert Oil, Inc.
Contractor: Jones-Gebert Oil, Inc.
Farm: #1 Stevens, C SW SW
Section 12-27S-20W
Kiowa County, Kansas
Commenced: 3/12/64
Completed: 3/26/64
Casing: 8-5/8" casing at 355' with
160 sx.

0	-	155	Surface Soil & Sand
155	-	180	Sand & Shells
180	-	525	Shale
525	-	650	Sand & Shells
650	-	1255	Shale with Sand Streaks
1255	-	1270	Shale & Shells
1270	-	1305	Anhydrite
1305	-	2085	Shale & Shells
2085	-	2595	Shale & Lime
2595	-	3135	Lime
3135	-	3575	Lime & Shale
3575	-	3700	Shale & Lime with Chalk Streaks
3700	-	3815	Shale & Chalk Streaks
3815	-	3880	Lime & Chalk Streaks
3880	-	4025	Lime & Shale
4025	-	4055	Lime
4055	-	4270	Lime & Shale
4270	-	4840	Lime
4840	-	4900	Dolomitic Chert
		4900	Rotary Total Depth

RECEIVED
STATE CORPORATION COMMISSION
APR 1 1964
CONSERVATION DIVISION
Wichita, Kansas

I, George R. Jones, do hereby certify that the above and foregoing is a true and correct copy of the log of the #1 Stevens, C SW SW, Section 12-27S-20W, Kiowa County, Kansas, as reflected by the files of Jones-Gebert Oil, Inc.




GEORGE R. JONES

State of Kansas, County of Sedgwick) ss:

Subscribed and sworn to before me, a Notary Public, in and for Sedgwick County, Kansas, this 31st day of March, 1964.

My Commission Expires:
January 8, 1968

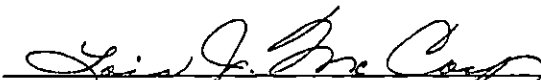

Lois J. McCoy, Notary Public