

STATE OF KANSAS
STATE CORPORATION COMMISSION

WELL PLUGGING RECORD

Give All Information Completely
Make Required Affidavit
Mail or Deliver Report to
Conservation Division
State Corporation Comm.
245 North Water
Wichita, KS 67202

Kiowa County, Sec. 14 Twp. 275Rge. 20W E/W
Location as "NE/CNW $\frac{1}{4}$ SW $\frac{1}{4}$ " or footage from lines
2710 FNL 330 FWL

Lease Owner Texas Oil & Gas
Lease Name Kilgore Well No. 1
Office Address Suite 300-200 W. Douglas, Wichita, Ks
Character of Well (Completed as Oil, Gas or Dry Hole)
Dry


Date Well completed 1-15 19 81
Application for plugging filed 6-23 19 81
Application for plugging approved 6-24 19 81
Plugging commenced 6-30 19 81
Plugging completed 7-13 19 81

Reason for abandonment of well or producing formation
Dry

If a producing well is abandoned, date of last production
No 19

Was permission obtained from the Conservation Division or
its agents before plugging was commenced? yes

Name of Conservation Agent who supervised plugging of this well M. V. Leslie
Producing formation _____ Depth to top _____ Bottom _____ Total Depth of Well 4960
Show depth and thickness of all water, oil and gas formations.

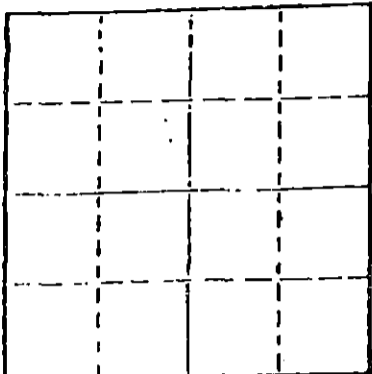

Locate well correctly on above
Section Plat

OIL, GAS OR WATER RECORDS

CASING RECORD

FORMATION	CONTENT	FROM	TO	SIZE	PUT IN	PULLED OUT
				10 3/4	95	None
				8 5/8	600	None
				4 1/2	4959	2549

Describe in detail the manner in which the well was plugged, indicating where the mud fluid was placed and the method or methods used in introducing it into the hold. If cement or other plugs were used, state the character of same and depth placed, from _____ feet to _____ feet for each plug set.

Dump sand from 4889 to 4825
4 sacks cement from 4825 to 4800
Ripped at 3800, 3500, 3300, 3100, 2549

Pumped in 15 gell 8 - hull 10 - gell
200 sacks 50 - 50 poz

RECEIVED
STATE CORPORATION COMMISSION

(If additional description is necessary, use BACK of this sheet)

Name of Plugging Contractor Clarke Corporation JUL 16 1981 7-16-81

STATE OF Kansas COUNTY OF Barker CONSERVATION DIVISION
Edmo R. Morgenstern (employee of owner) or (owner or operator)
Wichita, Kansas.
of the above-described well, being first duly sworn on oath, says: That I have knowledge of the facts, statements, and matters herein contained and the log of the above-described well as filed and that the same are true and correct. So help me God.

(Signature) Edmo R. Morgenstern
Medicine Lodge, Kansas
(Address)

SUBSCRIBED AND SWORN TO before me this 15th day of July, 1981

Jessie Hamilton
Notary Public.

My commission expires April 4, 1982

KANSAS DRILLERS LOG

COMPANY Texas Oil & Gas Corp.

SEC 14 T. 27S R. 20W

FARM Kilgore NO. 1

LOC 2310' FNL & 330' FWI

COUNTY Kiowa

ROTARY TOTAL DEPTH 4,960'

COMM. December 15, 1980 COMP January 1, 1981

CONTRACTOR H-30, INC. (Rig #77)

ISSUED January 15, 1981

CASING

95' of 16" Conductor cemented w/5 C.Y. cement
10 3/4"

8 5/8" Set at 600' cemented w/525 sxs cement

ELEVATION 2,311' K.B

5 1/2"

4 1/2" Set at 4,959' cemented w/125 sxs cement

FIGURES INDICATE BOTTOM OF FORMATIONS

Sand	1,049'
Red Bed	2,405'
Lime and Shale	2,640'
Shale and Shells	2,846'
Shale	3,605'
Shale and Lime	4,200'
Lime	4,438'
Lime and Shale	4,520'
Lime	4,646'
Lime and Chert	4,748'
Lime	4,885'
Lime and Chert	4,960'
Rotary Total Depth	4,960'

I hereby certify the above and foregoing to be a true and correct log of the above described well as shown by the drilling reports.

H-30, INC.

Dean Britting
Dean Britting

RECEIVED
STATE CORPORATION COMMISSION

JUN 24 1981

State of Kansas)
) ss:
County of Sedgwick)

CONSERVATION DIVISION
Wichita, Kansas

Subscribed and Sworn to before me a Notary Public
in and for said county and state this 15th day of
January, 1981.

Elsie Willison
Elsie Willison - Notary Public

My Commission Expires:

July 25, 1982