

STATE OF KANSAS
STATE CORPORATION COMMISSION

WELL PLUGGING RECORD

Give All Information Completely
Make Required Affidavit
Mail or Deliver Report to:
Conservation Division
State Corporation Commission
211 No. Broadway
Wichita, Kansas

KIOWA

County, Sec. 14 Twp. 27S Rge. (E) 20 (W)

Location as "NE/CNW/SW" or footage from lines C NE 1/4 SW 1/4

Lease Owner NORTHERN NATURAL GAS PRODUCING COMPANY

Lease Name FRALICK A Well No. 2

Office Address 610 UNION CENTER BUILDING WICHITA, KANSAS

Character of Well (completed as Oil, Gas or Dry Hole) SALT WATER DISPOSAL

Date well completed NOVEMBER 28, 19 60

Application for plugging filed NOVEMBER 22, (verbal approval) 19 60

Application for plugging approved FEBRUARY 6, (written approval) 19 61


Plugging commenced DECEMBER 29 (estimated) 19 60

Plugging completed JANUARY 13 19 61

Reason for abandonment of well or producing formation NON-PRODUCTIVE

If a producing well is abandoned, date of last production 19

Was permission obtained from the Conservation Division or its agents before plugging was commenced? YES

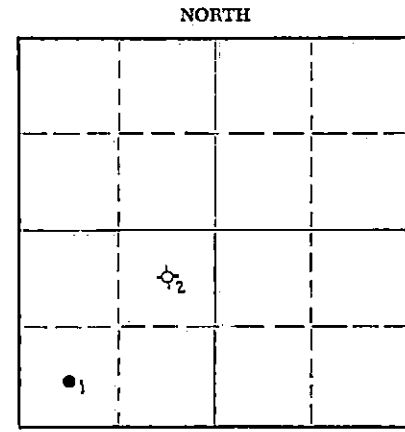

Locate well correctly on above Section Plat

Name of Conservation Agent who supervised plugging of this well W.L. LE CAMP

Producing formation MISS. CHAT Depth to top 4820 Bottom 4878 Total Depth of Well 4878 Feet

Show depth and thickness of all water, oil and gas formations.

OIL, GAS OR WATER RECORDS

CASING RECORD

FORMATION	CONTENT	FROM	TO	SIZE	PUT IN	PULLED OUT
Cheyenne Sand	Salt Water	549	618	8-5/8"	548	none
Chase Dolomite		2438	2750	4-1/2"	4878	4197
Toronto Limestone		4084	4096			
Lansing-Kan. City Lime		4208	4628			
Marmaton Limestone		4628	4741			
Cherokee Limestone		4741	4806			
Mississippi Lime & Chert	Water - Show	4806	4878			
	Oil & Gas					

Describe in detail the manner in which the well was plugged, indicating where the mud fluid was placed and the method or methods used in introducing it into the hole. If cement or other plugs were used, state the character of same and depth placed, from _____ feet to _____ feet for each plug set.

1. Plug back from PBD, Est. 4848' to 4815 with sand
2. Set 5 sx. cement plug from 4815' to 4755'
3. Shot off and pulled 4197' of 4-1/2" casing
4. Set rock plug 775' to 765'
5. Set 20 sx. cement plug from 765' to 614'

Note: All depths are from K.B.; deduct 10' to obtain depth from ground level.

Final plugging will be completed when no longer required as salt water disposal well.

RECEIVED
STATE CORPORATION COMMISSION
JUL 18 1961

CONSERVATION DIVISION
Wichita, Kansas

STA.

JUL - 3

CONSERVATION DIVISION
Wichita, Kansas

(If additional description is necessary, use BACK of this sheet)
Name of Plugging Contractor SOUTHWEST CASING PULLING COMPANY, INC.
Address P.O. BOX 364 GREAT BEND, KANSAS

STATE OF KANSAS, COUNTY OF SEDGWICK, ss.

DONALD L. HORTON, DISTRICT PRODUCTION ENGR (employee of owner) or (owner or operator) of the above-described well, being first duly sworn on oath, says: That I have knowledge of the facts, statements, and matters herein contained and the log of the above-described well as filed and that the same are true and correct. So help me God.

(Signature) Donald L. Horton
Donald L. Horton, P.E.
Northern Natural Gas Producing Co. 610 Un. Cent Bldg
Wichita, Kansas (Address)

SUBSCRIBED AND SWORN TO before me this 7th day of July, 1961

SANDRA KAY PEER, Notary Public
My Commission Expires Sept. 14, 1964

My commission expires

Notary Public.

