


STATE OF KANSAS  
STATE CORPORATION COMMISSION

Form CP-4

WELL PLUGGING RECORD

Give All Information Completely  
Make Required Affidavit  
Mail or Deliver Report to:  
Conservation Division  
State Corporation Commission  
P. O. Box 17027  
Wichita, Kansas 67217  
NORTH

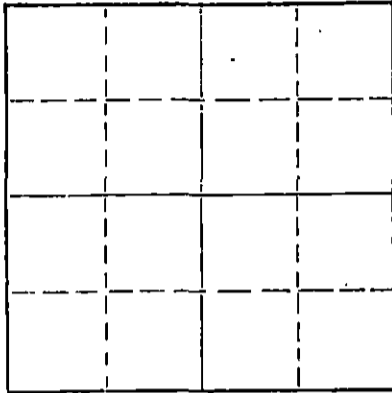

Locate well correctly on above  
Section Plat

Kiowa County, Sec. 4 Twp 27S Rge. (E) 20W(W)  
Location as "NE/CNW%SW%" or footage from lines C NE NE  
Lease Owner Okmar Oil Company  
Lease Name Einsel Ranch Well No. 1  
Office Address 1130 Vickers-KSB&T Bldg., Wichita, Kansas  
Character of Well (completed as Oil, Gas or Dry Hole) Dry Hole  
Date well completed 6-21 19 72  
Application for plugging filed 6-21 19 72  
Application for plugging approved 6-21 19 72  
Plugging commenced 6-21 19 72  
Plugging completed 6-21 19 72  
Reason for abandonment of well or producing formation No commercial  
quantities of oil or gas encountered.  
If a producing well is abandoned, date of last production 19  
Was permission obtained from the Conservation Division or its agents before plugging was com-  
menced? Yes

Name of Conservation Agent who supervised plugging of this well G. R. Biberstein  
Producing formation Depth to top Bottom Total Depth of Well 4877 Feet  
Show depth and thickness of all water, oil and gas formations.

OIL, GAS OR WATER RECORDS

CASING RECORD

FORMATION	CONTENT	FROM	TO	SIZE	PUT IN	PULLED OUT
Surface Hole	Water	Surface	604'	8-5/8"	596'	None

Describe in detail the manner in which the well was plugged, indicating where the mud fluid was placed and the method or methods used in introducing it into the hole. If cement or other plugs were used, state the character of same and depth placed, from feet to feet for each plug set.

plug  
Fluid to 500', 1/2 sx hulls, /50 sx cement;  
Fluid to 40', 1/2 sx hulls, plug, 15 sx cement;  
Three sacks cement in rat hole.

RECEIVED  
STATE CORPORATION COMMISSION  
JUN 27 1972  
CONSERVATION DIVISION  
Wichita, Kansas

(If additional description is necessary, use BACK of this sheet)  
Name of Plugging Contractor D N B DRILLING, INC.  
Address 701 First Nat'l Bldg., Wichita, Kansas 67202

STATE OF KANSAS, COUNTY OF ss.  
JAMES L. DONELSON (employee of owner) or (owner or operator) of the above-described well, being first duly sworn on oath, says: That I have knowledge of the facts, statements, and matters herein contained and the log of the above-described well as filed and that the same are true and correct. So help me God.

(Signature) James L. Donelson  
701 First Nat'l Bldg., Wichita, Kansas  
(Address)

SUBSCRIBED AND SWORN TO before me this 26th day of June, 19 72

My commission expires August 25, 1972

Ella Priess  
Ella Priess Notary Public.

The next time you do these forms  
why not put the office address  
just below the lease owner as you  
have on all your other forms.

2

DRILLERS' LOG

OKMAR OIL COMPANY  
1130 Wichita Plaza  
Wichita, Kansas 67202

Einsel Ranch #1  
C NE NE, Sec. 4-27S-20W  
Kiowa County, Kansas

Commenced: 6-12-72  
Completed: 6-21-72

Elev: 2296 R.B.

Surface Casing: 596.47' of  
8-5/8" cemented w/350 sx  
Howcolite, 100 sx Posmix, 3% cc.  
6-13-72

FORMATION

DEPTH

Surface Hole	0 - 604
Shale	604 - 1325
Shale & Lime	1325 - 2360
Lime & Shale	2360 - 2510
Lime	2510 - 2730
Lime & Shale	2730 - 3155
Lime	3155 - 3490
Lime & Shale	3490 - 3880
Lime	3880 - 4107
Lime & Shale	4107 - 4215
Lime	4215 - 4877 T.D.

I do hereby certify that the foregoing statements are true and correct to the best of my knowledge and belief.

D N B DRILLING, INC.

*James L. Donelson*  
JAMES L. DONELSON

RECEIVED  
STATE CORPORATION COMMISSION  
JUN 27 1972  
CONSERVATION DIVISION  
Wichita, Kansas

STATE OF KANSAS: ss:

Subscribed and sworn to before me, the undersigned, a Notary Public in and for said state, this 26th day of June 1972.

My Commission Expires:  
August 25, 1972

*Ella Priess*  
Ella Priess, Notary Public