


STATE OF KANSAS
STATE CORPORATION COMMISSION

WELL PLUGGING RECORD

Give All Information Completely
Make Required Affidavit
Mail or Deliver Report to
Conservation Division
State Corporation Comm.
245 North Water
Wichita, KS 67202

Kiowa County. Sec. 32 Twp. 27S Rge. 20W E/W
Location as "NE/CNW $\frac{1}{4}$ SW $\frac{1}{4}$ " or footage from lines C SW NE
Lease Owner Deck Oil Company
Lease Name Pearson Well No. #1
Office Address Suite 4000 - One Williams Center, Tulsa, OK
Character of Well (Completed as Oil, Gas or Dry Hole) Dry Hole
Date Well completed January 26, 1982
Application for plugging filed January 26, 1982
Application for plugging approved January 26, 1982
Plugging commenced 3:30 p.m. 19
Plugging completed 4:30 p.m. 19
Reason for abandonment of well or producing formation D & A
If a producing well is abandoned, date of last production None 19
Was permission obtained from the Conservation Division or its agents before plugging was commenced? yes

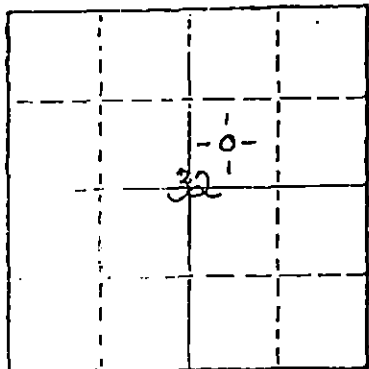

Name of Conservation Agent who supervised plugging of this well Paul Luthi
Producing formation X Depth to top X Bottom X Total Depth of Well 5000'
Show depth and thickness of all water, oil and gas formations.

OIL, GAS OR WATER RECORDS

CASING RECORD

FORMATION	CONTENT	FROM	TO	SIZE	PUT IN	PULLED OUT
				8 5/8"	631'	none

Describe in detail the manner in which the well was plugged, indicating where the mud fluid was placed and the method or methods used in introducing it into the hold. If cement or other plugs were used, state the character of same and depth placed, from _____ feet to _____ feet for each plug set.

Ran 40 sacks @ 620' Bridge Plug
10 sacks @ 40' Bridge Plug
10 sacks in Rat Hole
5 sacks in Mouse Hole

(If additional description is necessary, use BACK of this sheet)

Name of Plugging Contractor Trans-Pac Drilling, Inc.

STATE OF KANSAS COUNTY OF SEDGWICK, ss.
Phyllis Buchanan (employee of owner) or (owner or operator)
of the above-described well, being first duly sworn on oath, says: That I have knowledge of the facts, statements, and matters herein contained and the log of the above-described well as filed and that the same are true and correct. So help me God.

(Signature) Phyllis Buchanan
Phyllis Buchanan

(Address)

SUBSCRIBED AND SWORN TO before me this 1st day of February, 19 82

My commission expires _____

Sherry Wayman
Sherry Wayman Notary Public.

