


STATE OF KANSAS
STATE CORPORATION COMMISSION

WELL PLUGGING RECORD

Give All Information Completely
Make Required Affidavit
Mail or Deliver Report to
Conservation Division
State Corporation Comm.
245 North Water
Wichita, KS 67202

Kiowa County, Sec. 32 Twp. 27S Rge. 20WE4
Location as "NE/CNW $\frac{1}{4}$ SW $\frac{1}{4}$ " or footage from lines _____
Approx. 505' FNL & 700' FWL
Lease Owner Texas Oil & Gas Corp.
Lease Name Brensing Well No. 1
Office Address 200 W. Douglas-Suite 300, Wichita, KS
Character of Well (Completed as Oil, Gas or Dry Hole) 67202
Dry Hole

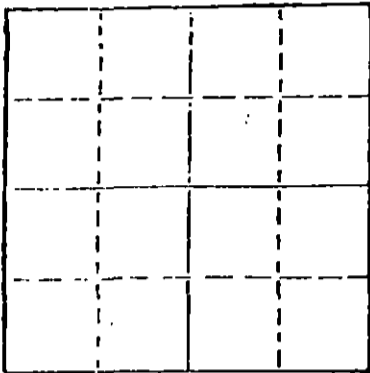

Locate well correctly on above
Section Plat

Date Well completed October 11, 1979
Application for plugging filed Verbal Application 1979
Application for plugging approved Verbal Approval 1979
Plugging commenced October 11, 1979
Plugging completed October 11, 1979
Reason for abandonment of well or producing formation _____

If a producing well is abandoned, date of last production _____
1979

Was permission obtained from the Conservation Division or
its agents before plugging was commenced? Yes

Name of Conservation Agent who supervised plugging of this well Wm. T. Owen
Producing formation _____ Depth to top _____ Bottom _____ Total Depth of Well 5,020'
Show depth and thickness of all water, oil and gas formations.

OIL, GAS OR WATER RECORDS

CASING RECORD

FORMATION	CONTENT	FROM	TO	SIZE	PUT IN	PULLED OUT
				8-5/8"	565'	None

Describe in detail the manner in which the well was plugged, indicating where the mud fluid
was placed and the method or methods used in introducing it into the hold. If cement or other
plugs were used, state the character of same and depth placed, from _____ feet to
_____ feet for each plug set.

Filled hole with heavy rotary mud from 5,020 ft. (rotary total depth) to
550 ft. Set plug at 550 ft. and cemented with 50 sacks cement. Filled hole
with heavy rotary mud from 550 ft. to 40 ft. Set solid plug at 40 ft. and
cemented to cellar with 10 sacks cement, 5 sacks in rat hole.

Plugging operations accomplished utilizing Halliburton Oil Well cementing
pump truck through 4 1/2 inch drill pipe.

(If additional description is necessary, use BACK of this sheet)

Name of Plugging Contractor Halliburton Services
Box 963, Pratt, Kansas 67124

STATE OF Kansas COUNTY OF Sedgwick, ss.
Dean Britting, Agent of owner XXXXXXXXXXXXXXXXXXXX

of the above-described well, being first duly sworn on oath, says: That I have knowledge of
the facts, statements, and matters herein contained and the log of the above-described well
as filed and that the same are true and correct. So help me God

(Signature) Dean Britting

200 N. Main, Wichita, KS 67202
(Address)

SUBSCRIBED AND SWORN TO before me this 19th day of October, 1979



Elsie Willison
Notary Public.

RECEIVED
STATE CORPORATION COMMISSION

My commission expires July 25, 1982

OCT 22 1979

CONSERVATION DIVISION
Wichita, Kansas

10-22-79

KANSAS DRILLERS LOG

COMPANY Texas Oil & Gas Corp.

SEC. 32 T. 27S R. 20W
 LOC. 505' PNL & 700' FWL

FARM Brensing NO. 1

COUNTY Kiowa

ROTARY TOTAL DEPTH 5,020'
 COMM. September 30, 1979 COMP. October 11, 1979
 CONTRACTOR H-30, INC. (Rig #3)
 ISSUED October 19, 1979

CASING

10 3/4"
 8 5/8" Set at 565' cemented w/425 sxs cement
 5 1/2"
 4 1/2"

ELEVATION 2,324' K.E.

FIGURES INDICATE BOTTOM OF FORMATIONS

Sand	95'
Red Bed and Shale	566'
Shale	1,191'
Lime and Shale	1,798'
Shale and Lime	2,189'
Lime and Shale	2,375'
Shale and Lime	2,545'
Lime and Shale	4,905'
Lime	5,020'
Rotary Total Depth	5,020'


I hereby certify the above and foregoing to be a true and correct log of the above described well as shown by the drilling reports.

H-30, INC.

Dean Britting
 Dean Britting

State of Kansas }
 County of Sedgwick } ss:

Subscribed and Sworn to before me a Notary Public in and for said county and state this 19th day of October, 1979.

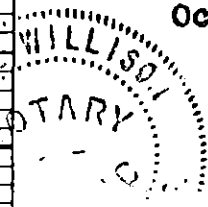

Elsie Willison
 Elsie Willison - Notary Public

My Commission Expires:

July 25, 1982